


Plot showing the location of well No. 257, of John L. Dungan et al. in Mineral County, West Virginia, to be abandoned on the 15th day of October, 1915, located in the oil and gas section of West Virginia.

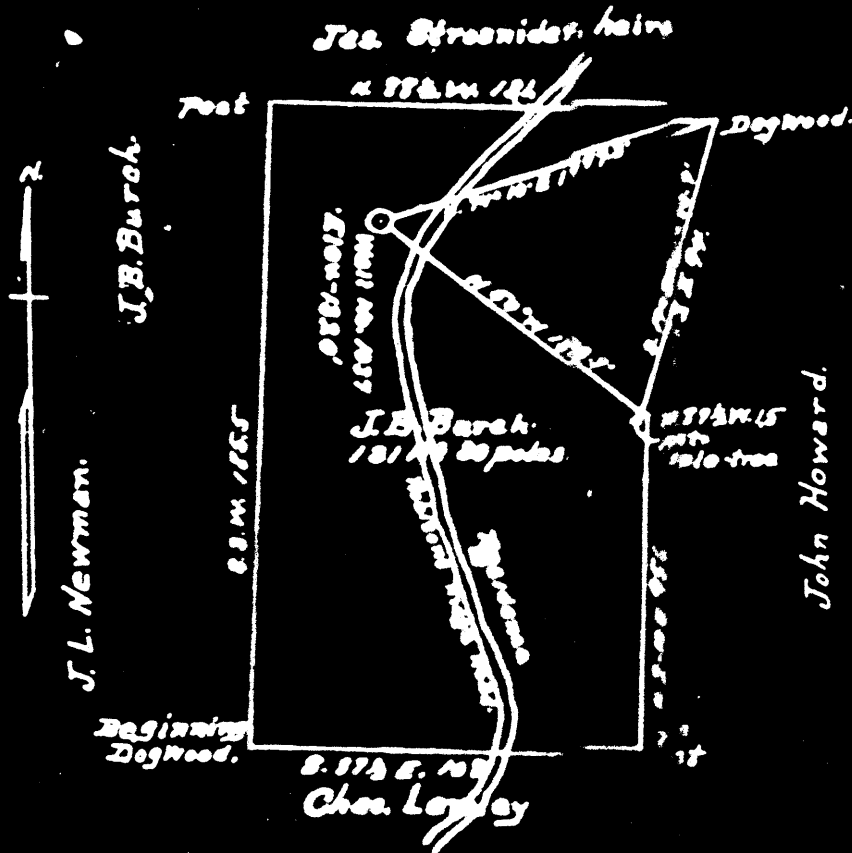

Engineer's Certificate

I, the undersigned hereby certify that this map is correct and shows all the information to the best of my knowledge and belief required by the oil and gas section of the Mining Laws of West Virginia.

A. Hadley
 Engineer.

Acknowledged before me & My public in and for Mineral County, West Virginia, this the 22 day of October, 1915.
 My Commission expires

WEST VIRGINIA DEPARTMENT OF MINES AND METALS

COAL OPERATOR OR OWNER

ADDRESS

COAL OPERATOR OR OWNER

ADDRESS

COAL OPERATOR OR OWNER

ADDRESS

FEDERAL ADDRESS

WELL AND LOCATION

W. No.

COPIES TO BE MADE IN TRIPLICATE ONE COPY TO BE KEPT BY REGISTERED OFFICE OF THE DEPARTMENT ONE COPY TO BE OBTAINED BY THE OPERATOR AND THE THIRD COPY (AND EXTRA COPIES IF REQUIRED) TO BE KEPT BY EACH COAL OPERATOR ABOVE NAMED AT THEIR RESPECTIVE ADDRESSES

AFFIDAVIT

STATE OF WEST VIRGINIA

COUNTY OF

MONROE

being first duly sworn according to law depose and say that they are experienced in the work of plugging and filling oil and gas wells and were employed by

and participated in the work of plugging and filling the above well that said work was commenced on

the day of

Manner in which sand was plugged

Manner in which coal was plugged

Description of monument

16 ~~Jan~~ 1935
Jan