.67w

Latitude

Longitude

Topo Location

7.5' Loc.______ 15' Loc._____ (calc.)

Company South Penn Oil Co


Farm LS Hort #65

7.5' Quad Pine Grove

District GRANT

WELL LOCATION PLAT

County 103 Permit 30158

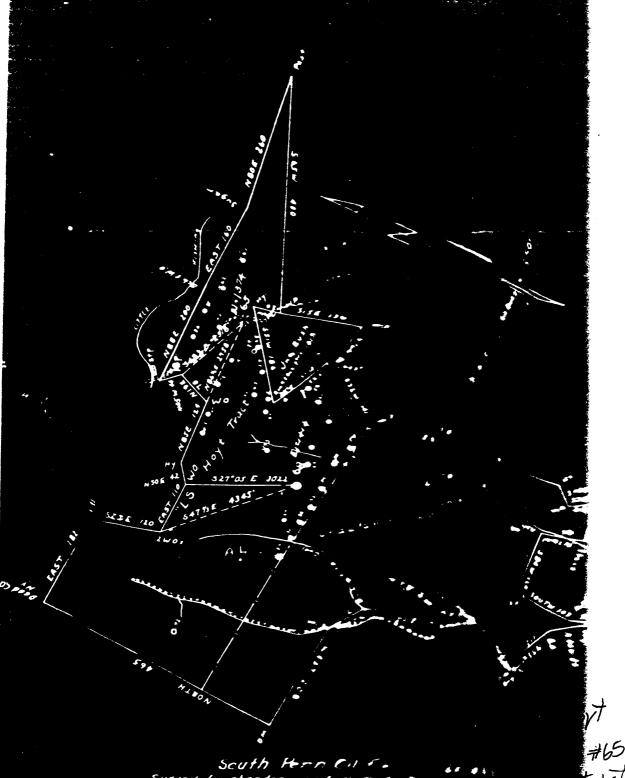

30158 LS HOYT #65 GRANT dist Grant District, Wetzel County, W. Va.

South Penn Oil Cc., Chamber of Commerce Bldg., Pitteburgh, Pa.

On 1100 acres, surface and mineral rights owned by Alex Crawford Moyt et al., New Castle, Pa.

Elevation, 1374.L.

108 casing, 760: (620 pulled): 82 casing, 1763: 6-5/8, 2501.

Coal was encountered at 1270-1275 (thick. est.)

Abandoment reported to Dept. of Mines July 8, 1935.

WET 158 A

	Top.	Bottom.
Pittsburgh Coal	1270	
Big Injun Sand	Sjidji	- 2715
Stray Sand	3264	- 3269
Gordon Sand (oil, 3307'), to bottom	3301	- 3321