

39° 42' 30"

Latitude

80° 37' 30"

Longitude

+
2.88s
.37

Topo Location

7.5' Loc. _____ 15' Loc. _____
_____ (calc.) _____

Company South Penn Oil Co.

Farm Marion Gorby #1

15' Quad _____
(sec.)

7.5' Quad Wileyville

District Center

WELL LOCATION PLAT

County 103 Permit 30160

V. L. P...
family
Map of State of Ohio

Mr Smith

Webster Allen
family
Joe Pyles

Marion Gorby
Wiloyville, W. Va.
892

Coal - Title in State
and eye - in name Ad. Colver


Berta Shuman Br

Runway Run or Rocky Run

ELIEN LI

Rebecca N Crane

Mr Smith - family v. Lamasters

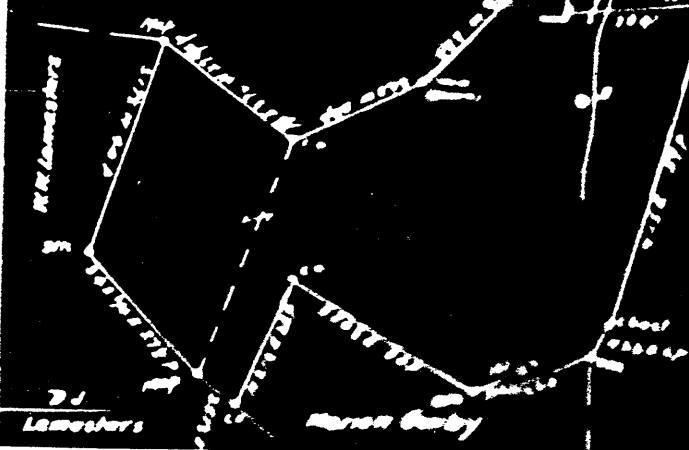

30160

V. L. Throckmorton
formerly
Manager of State of Bridge

1898 200 1877

Ac 400 Ac 2105

Webster Allen
formerly
Joe Pyles

Marion Gurby
Wichita, Ks.
875

Coal - Title in State
held 1902 - in name Ada Colwell

Bertie Shuman Br

Embury Run or Rocky Run

E 1230 21'

Wm. Smith - formerly J.H. Lamasters

N 24 180 1/2

E 1231 047

Rebecca N Crane

R.H. Lamasters

N 40 12 1/2

21
Lamasters

Marion Gurby

Embury Run

NOT FOUND FILES → Assign #

NOW 30160
Oil and Gas Data System
Form Revised: November 7, 1986

DATA REVISED BY: Wetzel

STRATIGRAPHY (REVISION)

DATA SOURCE: CR 103 - p. 445

Fill in the ID information, the FORMATION CODE involved and then only the fields to be modified!

ID: COUNTY _____ PERMIT _____ SUFFIX _____

Location
Loc. Source: Marion Gorbey #1 (MARION GORBAY)
South Penn Oil Co.

CR Map # 74

FORMATION CODE	FM QUALITY	DEPTH FEET	DEPTH QUALITY	THICKNESS FEET	THICKNESS QUALITY	ELEVATION	TAKEN FROM
1	229 Pth Coal	1031		6			I
2	247 Dunbar ss	1660		50			
3	170 EOL	1690		6			
4	257 Gas Sand	1860		50			
5	285 Salt Sand	2125		50			
6	345 Big Lime	2252		78			
7							
8							
9							
10							

Coaler District
1 1/4 mi S of Silver Hill,
Glen? - (Topo)
N 1260
(from CR Map
1 1/2 mi. S. Road)

Wileyville Ohio

ENTERED IN COMPUTER 2/92

MARION GORBY NO. 1 WELL.

No. 453 O.F. (Wetzel)

Center District, Wetzel County, W. Va.
South Penn Oil Co., Chamber of Commerce Bldg., Pittsburgh, Pa.
On 50 acres, surface and mineral rights owned by Marion Gorby,
Wileyville, W. Va.

Ab R 160 A

Elevation, 1218.21' L.

13" casing, 128'; 10", 1444'; 8 1/4", 1908'; 1" (pulled); 6-5/8", 2355'.

Coal was encountered at 1025-1030 and 1131-1137'.

181' of 5-3/16" liner.

Abandonment reported to Dept. of Mines July 8, 1935.

Well was shot 7-14-20, with 60 qts.

	Top.	Bottom.
Mapletown Coal	1025	- 1030
Pittsburgh Coal	1131	- 1137
Dunkard Sand	1660	- 1710
Gas Sand	1860	- 1910
Salt Sand	2125	- 2175
Big Lime	2257	- 2335
Big Injun Sand (1st gas, 2362'; 2nd gas, 2426')	2336	- 2587
Gordon Sand, to bottom	3174	- 3195