


Plat of the location of well No. 6  
on the New Martinsville Bank farm, owned  
by the Hopewell Natural Gas Company on  
an acre of 38 acres, located in  
Green District, Wetzel County, West  
Virginia, to be plowed and abandoned.

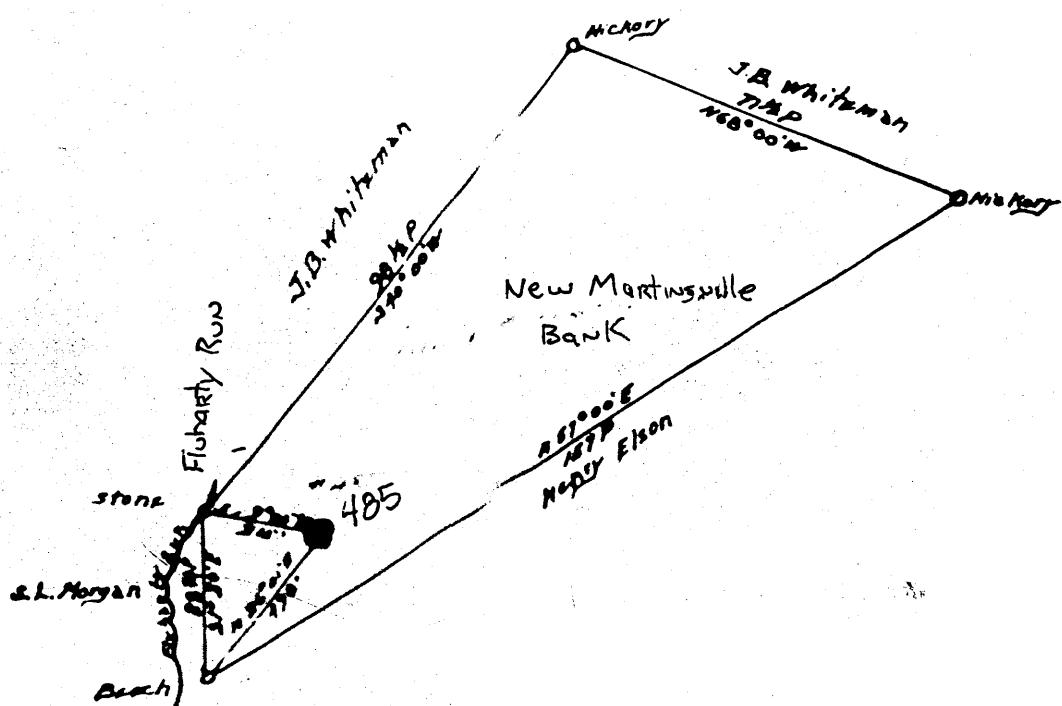

I, the undersigned, being satisfied  
that this map is correct and agrees  
with the location and belief, - enclosed by the  
Plan of West Virginia.

John M. Martin

Attest, this 22<sup>nd</sup> day of October 1935

John M. Martin

My affd  
John M. Martin

Green District, Wetzel County, W. Va.

By Hope Construction &amp; Refining Co.

Abandoned under permit No. 186.

Drilling commenced Nov. 8, 1915; completed, Dec. 15, 1915.

13" casing, 166'; 10", 1163'; 8", 1659'; 6", 1832'; 2" tubing, 1969'.

Derrick records: 10" shoe, 1153'; 8" shoe, 1651'; 6 x 8 N. H., 1515'.

Shot Jan. 27, 1916, with 30 gts. in Big Injun Sand.

Record on Hope form not dated; notation on margin, 11-2-35 (by E. H.)

Record to 182 free hrs. Griffith Sept. 16, 1932.

Direction.....

	Top.	Botton.
Pittsburgh Coal (SLM, 571')	570 - 571	
Little Standard Sand	930 - 1020	
Gas Sand	1260 - 1284	
First Coal Sand	1475 - 1510	
Second Coal Sand (gas, 1670-73')	None	
Marton Sand	1723 - 1732	
Little Lime	1765 - 1781	
Pencil Cave	1781 - 1791	
Big Lime	1791 - 1895	
Big Injun Sand (nat., 1915') (ell, 1915') oil, 1920-46'; gas, 1933-55')	1915 - ....	
Total depth		1965