

Well to be Abandoned


Company	South Penn Oil Co
Address	411 7th Ave Pittsburgh, Pa
Form	Wm M Reynolds
Tract - Acres	52 Lease No. 13808
Well (Form) No	4 Serial No. -
Quadrangle	Littleton
County	Wetzel
District	Clay

STATE OF WEST VIRGINIA
DEPARTMENT OF MINES
OIL AND GAS DIVISION
CHARLESTON

WELL LOCATION MAP
FILE NO. WEI-208

• Denotes location of well on United States
Geographic Maps, scale 1 to 62,500 feet
and leasehold lines have been indicated

30205

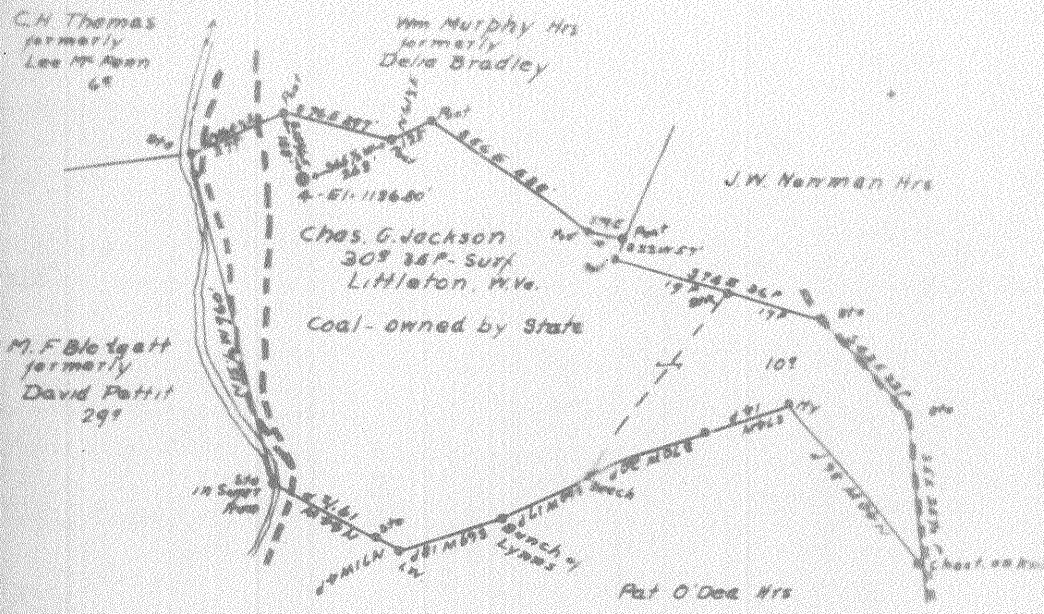

Well to be Abandoned

Company	South Penn Oil Co
Address	611-7th-Ave Pittsburgh, Pa
Farm	Wm Mc Reynolds
Traet	- Acres 32 Lessee No. 12808
Well (Farm) No.	4 Serial No. -
Quadrangle	Littleton
County	Wayne
District	Clay

STATE OF WEST VIRGINIA
 DEPARTMENT OF MINES
 OIL AND GAS DIVISION
 CHARLESTON

WELL LOCATION MAP
 FILE NO. WET-205

* Denotes location of well on United States
 Topographic Maps, scale 1 to 62,500. lat.
 and longitude lines shown

Clay District, Wetzel County, W. Va.

By South Penn Oil Co., Chamber of Commerce Bldg., Pittsburgh, Pa.

Abandoned under permit Wet-205, issued 7-13-36. (July report).

On 52 acres, surface owned by Chas. G. Jackson, Littleton, W. Va.,
and minerals by S. P. Carney, 141 Lee Ave., Clarksburg, W. Va.

Elevation, 1136.80' L.

Conductor, 11"; 10" casing, 170' (pulled); 8½", 1367' (pulled);

6⅝", 2122'; 5⅜", 2402'.

Coal was encountered at 886-892'.

Abandonment reported to Dept. of Mines June 30, 1936.

Well was shot in Fourth Sand, with 40 qts., May 3, 1918.

Oil well. Record to RCT from Mrs. Griffith Sept. 16, 1938.

	Top.	Bottom.
Pittsburgh Coal	886	- 892
Dunkard Sand	1367	- 1420
Gas Sand	1600	- 1650
Salt Sand	1850	- 1900
Big Injun Sand	2167	- 2380
50-Ft. Sand	2862	- 2880
Gordon Sand	2941	- 2994
Fourth Sand	3055	- 3063
Total depth		3073