


40?

LONGITUDE 80° 30'

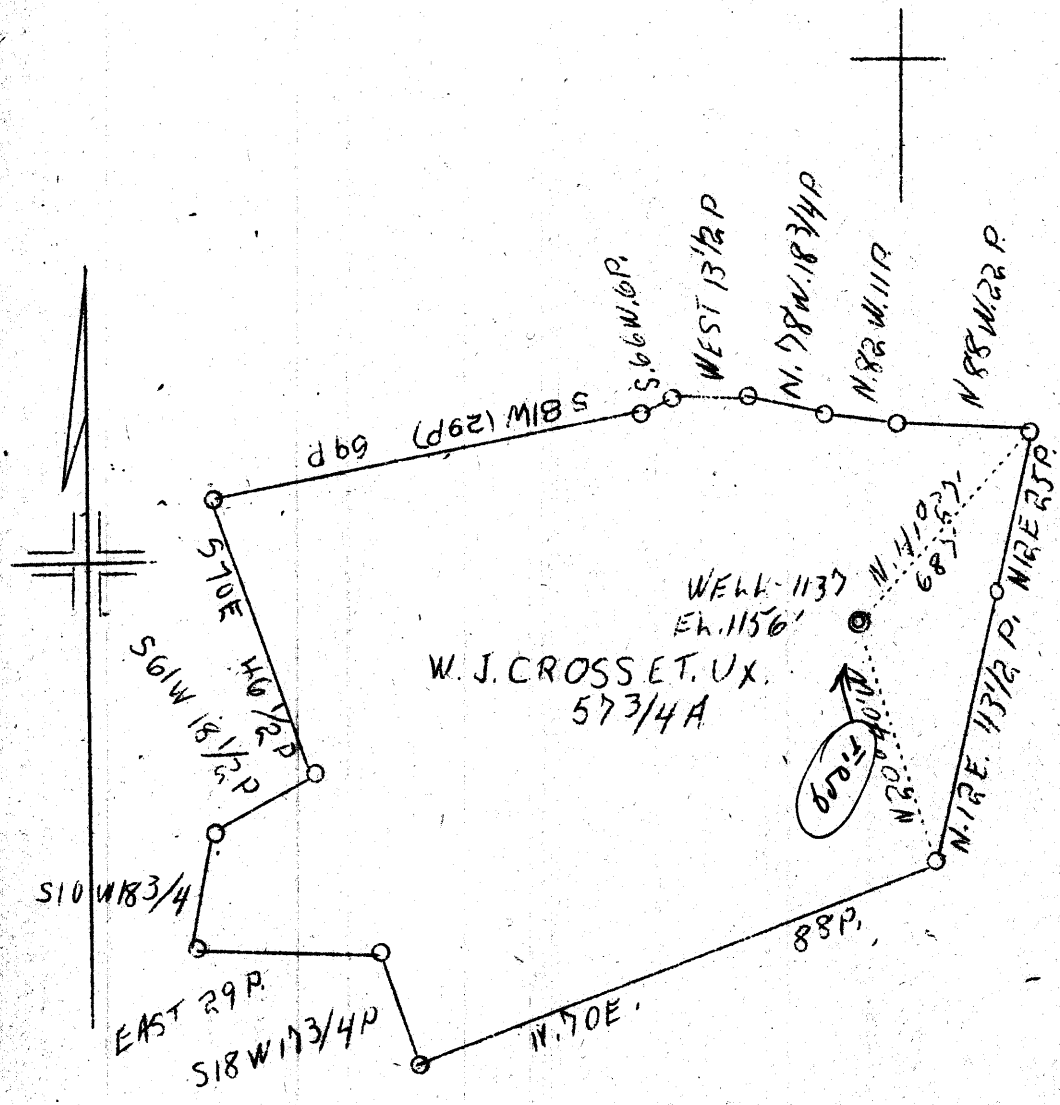

136/65

244

249 W
1192

COAL OWNED BY THE Littleton Fuel Company

MAY - 9 1938

Company	The Manf. Light and Heat Co.
Address	800 Union Trust Bldg., Pittsburgh Pa.
Farm	W. J. Cross et ux
Tract	Acres 57 ³ / ₄ Lease No. 2966
Well (Farm) No.	1 Serial No. 1137
Elevation (Spirit Level)	1155'
Quadrangle	Littleton
County	Wetzel District Center
Engineer	H. D. O'Connor
Engineer's Registration No.	
File No.	Drawing No. 1-11-38

STATE OF WEST VIRGINIA ✓
 Department of Mines
 OIL AND GAS DIVISION
 CHARLESTON

WELL LOCATION MAP
 File No. Wet-266-A

Denotes location of well on United States Topographic Maps, scale 1 to 62,500, latitude and longitude lines being represented by border lines as shown.
 Denotes one inch spaces on border line of original tracing.

