


LATITUDE 39° 45'

LONGITUDE 80° 20'

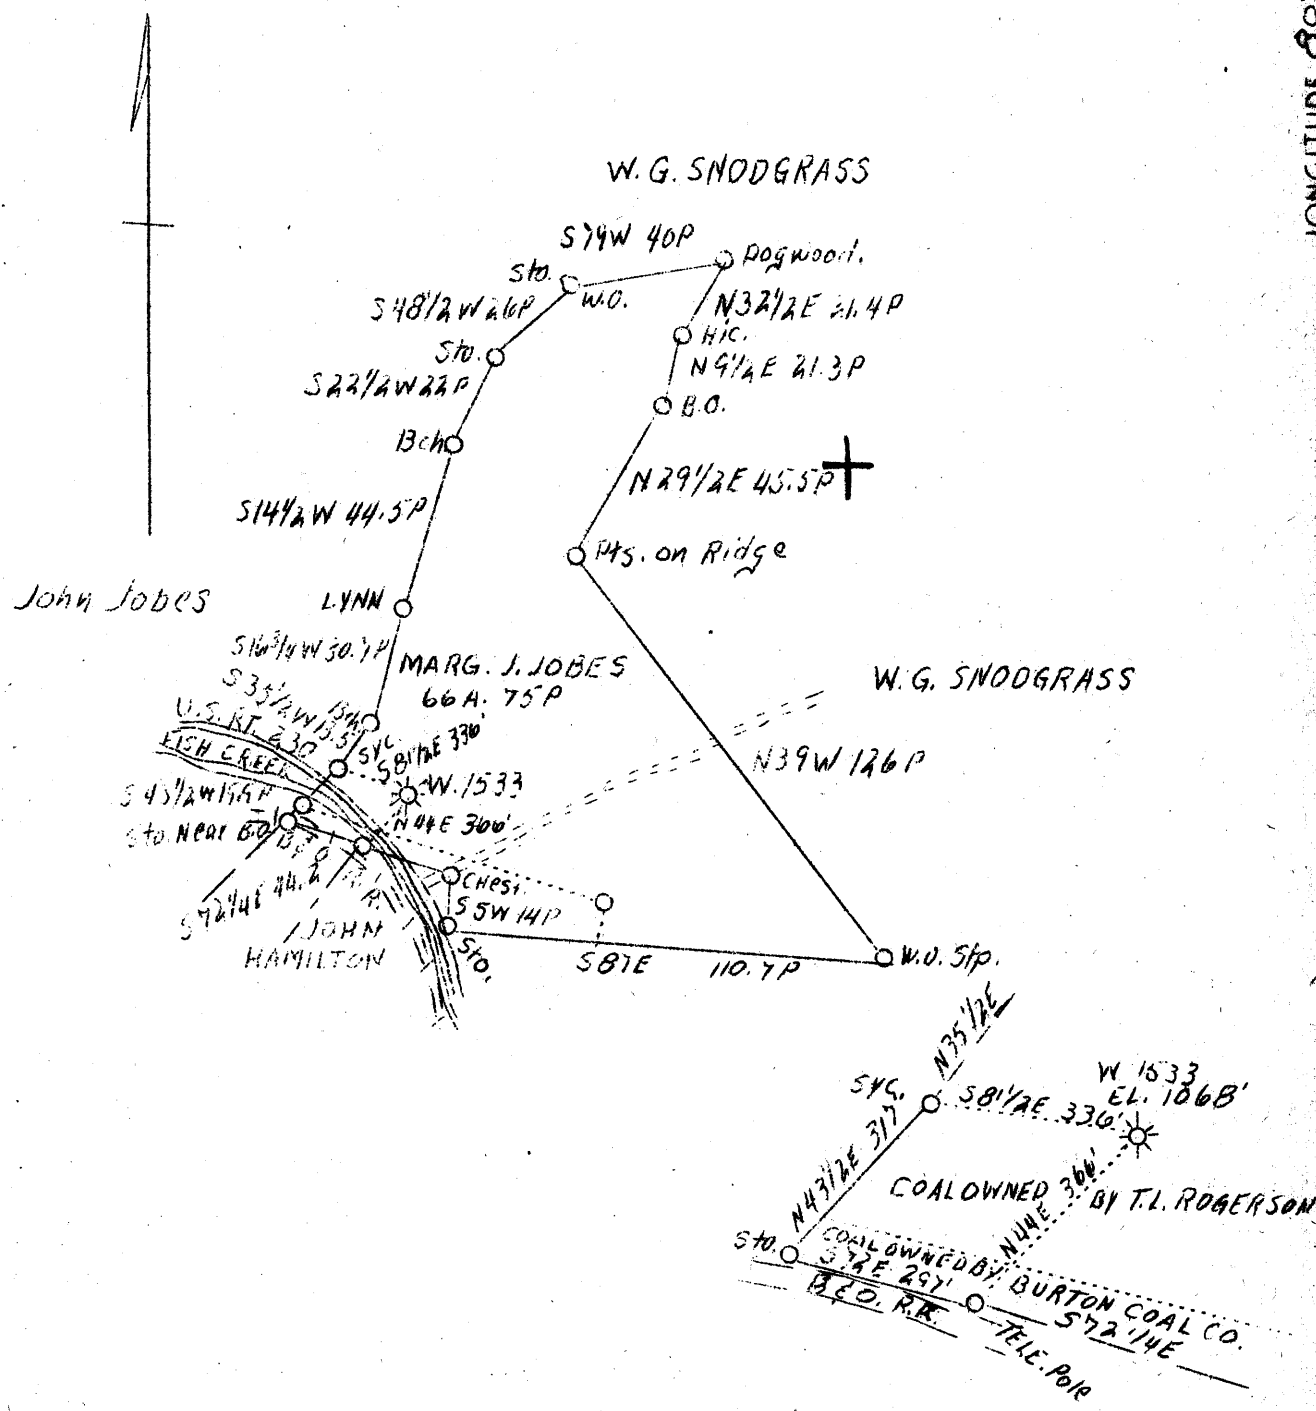

Well Abd.
Coal owned by T.L. Rogerson

APR 10 1939

DETAIL OF LOCATION
2.51 ~~2154W~~
3.91 ~~395P~~

Company The Mfg. Light & Heat Co.
 Address 800 Union Tr. Bldg. Pittsburgh
 Farm Margaret Jane Jobes ET. COM.
 Acres 66 - 75 P
 Lease No. 2753
 Serial No 1533
 Well (Farm) No. 1
 El. (Sp. L.) 1068
 Quadrangle Mannington N.W.
 County Wetzel
 District Church
 Eng. J. C. Mercer
 Drawing No. Y - 8 - 232
 Date 3/30/39
 Scale 1" = 800'

(Handwritten initials)

STATE OF WEST VIRGINIA
Department of Mines
OIL AND GAS DIVISION
Charleston

WELL LOCATION MAP

File No. Wet-291-A

x Denotes location of well on U.S. Topographic Maps; scale 1 to 62,500, latitude and longitude lines being represented by border lines as shown.

- Denotes one inch spaces on border line of original tracing.

WEST VIRGINIA DEPARTMENT OF MINES
OIL AND GAS DIVISION

765

WELL RECORD

APR 1912
Permit No. Drilled in 1912

Oil or Gas Well Gas
(Kind)


Company The Manufacturers Light & Heat Co.
 Address 800 Union Trust Bldg., Pittsburgh, Pa.
 Farm Margaret J. Jobes Acres 67
 Location (waters) _____
 Well No. 1 - 1533 Elev. _____
 District Church County Wetzel
 The surface of tract is owned in fee by Margaret J. Freeman
 Address Hundred, W. Va.
 Mineral rights are owned by The Manufacturers Light & Heat Co.
 Address Pittsburgh, Pa.
 Drilling commenced Sept. 12, 1912
 Drilling completed Dec. 23rd, 1914
 Date shot _____ Depth of shot _____
 Open Flow _____ /10ths Water in _____ Inch
 _____ /10ths Merc. in _____ Inch
 Volume _____ Cu. Ft.
 Rock Pressure 100 lbs. 1 hrs.
 Oil _____ bbls., 1st 24 hrs.
 Fresh water _____ feet _____ feet
 Salt water _____ feet _____ feet

Casing and Tubing	Used in Drilling	Left in Well	Packers
Size			
16.			Kind of Packer
13.			
10.	<u>24 1'</u>	<u>24 1'</u>	Size of
8 3/4.	<u>1331'</u>	<u>1331'</u>	
6 5/8.	<u>2032</u>	<u>2032</u>	Depth set
5 3/16.			
3.			Perf. top
2.			Perf. bottom
Liners Used			Perf. top
			Perf. bottom

CASING CEMENTED _____ SIZE _____ No. FT. _____ Date _____
 COAL WAS ENCOUNTERED AT 150 FEET 60 INCHES
715 FEET 72 INCHES 818 FEET 108 INCHES
 _____ FEET _____ INCHES _____ FEET _____ INCHES

Formation	Color	Hard or Soft	Top	Bottom	Oil Gas or Water	Depth Found	Remarks
Waynesburg Coal			150	155			
Mapleton Coal			715	721			
Pittsburgh Coal			818	827			
Little Bushard			1160	1190			
Big Bushard			1348	1388			
Gas Sand			1460	1500			
Salt Sand		Drilled deeper	1568	1855	Gas 1570		
Maxon Sand			1862	1880			No packer or tubing in well shut in 8 1/4" casing
Little Line			1955	1965			
Big Line			1986	2037			
Big Injun			2037	2300	Gas at 2047		
Fifty Feet Sand			2777	2785			
Thirty Feet Sand			2828	2862	Show of gas	2862	
Gordon Sand			2938	2956			
Fourth Sand			3019	3027	Gas 3023		
Fifth Sand			3058	3078			
Total depth				3117			

New Fty. ~ 1579'

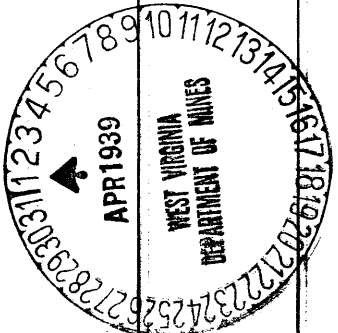

MAY 21 1939

