_
0
3
9
-
•
Q

Topo Location

Latitude


7.5'	Loc		15'	Loc	•
			(ca	ilc.)	
					

Farm TM + AC Stone *2 15' Quad ____ (sec.) 7.5' Quad PINE GROVE District GRONT

Company WN Miller

WELL LOCATION PLAT

County 103 Permit 30323

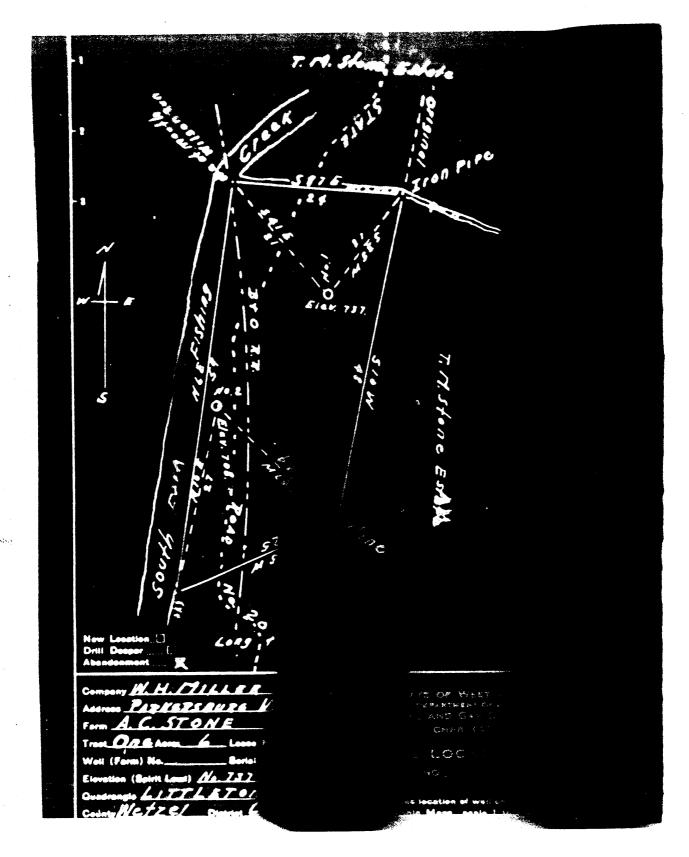

B. 1940 WELL AND LOCATION

& A.C.Stone (L.StoneAdmx)
Courtney

STATE OF WEST VIRGINIA

County of Harrison

Lyda Simon

being first duly sworn as conding to less depose and

and filling oil and gas we's and were employed by and participated in the work of plugging and filling

8th day of May following manner

194 \$

SAND OR ZONE RECORD PORMATION Clay Kaxon Sand Plug File Clay Salt Sand Plug Plug Permanent B Plug Dunkard Sand Clay Plug Permanent Brid Coment Clay

experienced in the work of plugging

, well operator
at said work was commenced on the

well was plugged and filled in the

	CABING			
ALED ALED	C90			
/16" 38'	-			
n .				
	-			
•	ñ 1			

DESCRIPTION OF MONUMENT

Belle Ver

a Simon