

COAL NOT OPERATED.

New Location   
 Drill Deeper   
 Abandonment

SEP 17 1940

2.76  
 2.38  
 0.8W  
 2.4R

Company H. E. MILLIKEN, ET AL.  
 Address Waynesburg, Pa.  
 Farm N. B. Dunham  
 Tract ONE Acres 27.9 Lease No. \_\_\_\_\_  
 Well (Farm) No. ONE Serial No. 490  
 Elevation (Spirit Level) 840'  
 Quadrangle Littleton  
 County Netzel District Proctor  
 Engineer A. L. Headley  
 Engineer's Registration No. \_\_\_\_\_  
 File No. \_\_\_\_\_ Drawing No. \_\_\_\_\_  
 Date 2-24-1940 Scale 1 inch = 20 poles

STATE OF WEST VIRGINIA  
 DEPARTMENT OF MINES  
 OIL AND GAS DIVISION  
 CHARLESTON

WELL LOCATION MAP  
 FILE NO. WET-343A

+ Denotes location of well on United States Topographic Maps, scale 1 to 62,500. latitude and longitude lines being represented by border lines as shown.

- Denotes one inch spaces on border line of original tracing.

STATE OF WEST VIRGINIA  
DEPARTMENT OF MINES  
OIL AND GAS DIVISION

810

WELL RECORD

Permit No. 343-A


Oil or Gas Well Oil  
(KIND)

Company H. E. Milliken, et al.  
Address Waynesburg, Pa.  
Farm N. B. Dunham Acres 27.9  
Location (waters) Fish Creek  
Well No. 1 (H. C. & R. Co. #490) Elev. 840  
District Proctor County Wetzel  
The surface of tract is owned in fee by N. B. Dunham  
Address Wileyville, W. Va.  
Mineral rights are owned by \_\_\_\_\_  
Address \_\_\_\_\_  
Drilling commenced ?  
Drilling completed 7-18-1910  
Date shot 7-25-19 Depth of shot 2794  
Open Flow /10ths Water in \_\_\_\_\_ Inch  
/10ths Merc. in \_\_\_\_\_ Inch  
Volume \_\_\_\_\_ Cu. Ft.  
Rock Pressure \_\_\_\_\_ lbs. \_\_\_\_\_ hrs.  
Oil \_\_\_\_\_ bbls., 1st 24 hrs.  
Fresh water None recorded feet \_\_\_\_\_ feet  
Salt water None recorded feet \_\_\_\_\_ feet

Casing and Tubing	Used in Drilling	Left in Well	Packers
Size			Kind of Packer
16			
13			
10	<u>287</u>	<u>Pulled</u>	Size of
8 1/4	<u>1304</u>	<u>Pulled</u>	
6 5/8	<u>1958</u>	<u>1958</u>	Depth set
5 3/16	<u>2573</u>	<u>2573</u>	
3			Perf. top
2	<u>2830</u>	<u>2830</u>	Perf. bottom
Liners Used			Perf. top
			Perf. bottom

CASING CEMENTED \_\_\_\_\_ SIZE \_\_\_\_\_ No. Ft. \_\_\_\_\_ Date \_\_\_\_\_  
Not cemented  
COAL WAS ENCOUNTERED AT 790 FEET 24 INCHES  
FEET \_\_\_\_\_ INCHES FEET \_\_\_\_\_ INCHES  
FEET \_\_\_\_\_ INCHES FEET \_\_\_\_\_ INCHES

Formation	Color	Hard or Soft	Top	Bottom	Oil, Gas or Water	Depth Found	Remarks
<u>Pittsburgh Coal</u>			<u>790</u>	<u>792</u>			
<u>Dunkard Sand</u>			<u>1160</u>	<u>1316</u>			
<u>Salt Sand</u>			<u>1485</u>	<u>1625</u>			
<u>Maxon Sand</u>			<u>1833</u>	<u>1860</u>			
<u>Big Injun Sand</u>			<u>1980</u>	<u>2215</u>			
<u>Gordon Stray Sand</u>			<u>2794</u>	<u>2806</u>	<u>Oil</u> <u>Gas</u>	<u>2794</u> <u>2794</u>	
		<u>Total depth</u>		<u>2824</u>			

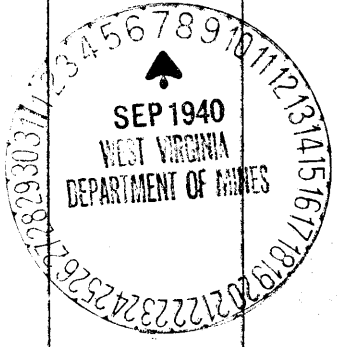

Formation	Color	Hard or Soft	Top	Bottom	Oil, Gas or Water	Depth Found	Remarks

Date September 6, 1940., 194...

APPROVED H. E. Milliken, et al., Owner

By A M Snider  
(Title)