

New Location
 Drill Deeper
 Abandonment X

Company CARNEGIE NATURAL GAS
 Address PITTSBURGH, PA.
 Farm MARY (J.H.) FURBEE
 Tract _____ Acres 346 ³/₄ Lease No. E-3716-74
 Well (Farm) No. 2 Serial No. 209
 Elevation (Spirit Level) 1620
 Quadrangle Pittston SE
 County WETZEL District GRANT
 Engineer R.I. RITCHIE; R.L. SRENEY
 Engineer's Registration No. _____
 File No. _____ Drawing No. _____
 Date JAN 10, 1941 Scale 1"=200'

STATE OF WEST VIRGINIA
 DEPARTMENT OF MINES
 OIL AND GAS DIVISION
 CHARLESTON

WELL LOCATION MAP
 FILE NO. WET-351A

+ Denotes location of well on United States Topographic Maps, scale 1 to 62,500, latitude and longitude lines being represented by border lines as shown

- Denotes one inch spaces on border line of original tracing.

75' Big Run

MARY (J.H.) FURBEE NO. 2 (209) - CARNEGIE NAT GAS CO. - WET-351-A

824

WEST VIRGINIA DEPARTMENT OF MINES
OIL AND GAS DIVISION

WELL RECORD

Ab
Permit No. 351-A

Oil or Gas Well. **GAS**
(Kind)

WELL TO BE ABANDONED.

Company **CARNEGIE NATURAL GAS COMPANY**
Address **1014 Friek Bldg., PITTSBURGH, PA.**
Farm **J. H. FURBEE** Acres **400**
Location (waters) **WILEY FORK**
Well No. **2-209** Elev. **1620**
District **GRANT** County **WETZEL**
The surface of tract is owned in fee by **SEE BELOW**
Address
Mineral rights are owned by **SEE BELOW**
Address
Drilling commenced **10-26-10** -- D.D. **8-1-11.**
Drilling completed **12-16-10** --
Date shot. Depth of shot.
Open Flow /10ths Water in. Inch
4 /10ths Merc. in. **6-5/8"** Inch
Volume **2,725,000** Cu. Ft.
Rock Pressure lbs. hrs.
Oil **show at 2130'** bbls., 1st 24 hrs.
Fresh water feet feet
Salt water **2055** feet **2065** feet


Casing and Tubing	Used in Drilling	Left in Well	Packers
Size			Kind of Packer
16.			
13.			
10.			Size of
8 3/4		1633'	
6 5/8		2152'	Depth set
5 3/16		2152'	
3.			Perf. top
2.		3313'	Perf. bottom
Liners Used			Perf. top
			Perf. bottom

CASING CEMENTED. SIZE No. FT. Date
COAL WAS ENCOUNTERED AT **640** FEET INCHES
740 FEET INCHES **705** FEET INCHES
1042 FEET INCHES **1137** FEET INCHES

Formation	Color	Hard or Soft	Top	Bottom	Oil Gas or Water	Depth Found	Remarks
Surface Coal			640'	643'			
Native Coal			740	743			
Fairview Coal			785	789			
Mapletown Coal			1042	1046			
Pittsburgh Coal			1137	1143			
Murphy Sand			1163	1208			
Little Dunkard			1508	1585			
Big Dunkard			1626	1666			
Sand			1740	1760			
1st Gas Sand			1804	1839			
1st Salt Sand			1880	1985	Gas at 1900'. Water at 2055' and 2065'.		
2nd Salt Sand			2020	2098			
3rd Salt Sand			2108	2173	Show of Oil, 2130'.		
Maxon Sand			2298	2306			
Little Lime			2315	2346			
Pencil Cave			2346	2350			
Big Lime			2350	2413			
Big Injun			2413		Gas 2424'-2434'.		
TOTAL DEPTH 12/16/10				2452'			
Big Injun				2550			
30-Ft. Sand			3100	3125			
Gordon Stray			3185	3205	Show of Gas, 3200'.		
Gordon Sand			3223	3275	Gas 3257'-3259'.		
4th Sand			3290	3315			
TOTAL DEPTH				3355'			

OWNERS of SURFACE and MINERAL RIGHTS:

Mary H. Furbee, Mannington, W.Va.
Mary H. Furbee, Howard R. Furbee,
and Robert D. Furbee, Trustees,
Estate of W.S. Furbee, Mannington, W.Va.

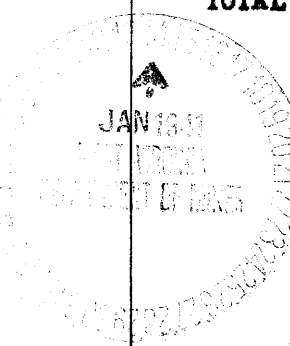

Formation	Color	Hard or Soft	Top	Bottom	Oil, Gas or Water	Depth Found	Remarks

Date..... **January 13,** 19**41.**

APPROVED..... **CARNEGIE NATURAL GAS COMPANY**....., Owner

By..... *D. N. Archer*..... Land Agent.
(Title)