

Latitude 39° 30'

Longitude 80° 30'

Robinson Imp. Co.

Peter Starkey
150 ac

Robinson Improvement Co.

Now
C.C. Bates

Fountain
Hood

Clarinda Hayhurst

Ab Ash

Town Lots.

Robinson Imp. Co.

Coal: Robinson Improvement Co.
The Plains, Va.

Surface: C.C. Bates
Folsom, W. Va.

New Location...
Drill Deeper...
Abandonment...

AUG 25 1941

N3 E 7

Map. N49

#6	1.2 ASW 1.49
#8	0.93 W 1.53

Company South Penn Natural Gas Co.
 Address Parkersburg, W. Va.
 Farm Peter Starkey
 Tract _____ Acres 150 Lease No. 46775
 Well (Farm) No. 6 & 8 Serial No. _____
 Elevation (Spirit Level) 6 = 1357.35 8 = 1359.96
 Quadrangle Centerpoint
 County Wetzel District Grant
 Engineer E.C. Tabler
 Engineer's Registration No. _____
 File No. _____ Drawing No. _____
 Date July 18, 1941 Scale 1" = 800'

STATE OF WEST VIRGINIA
DEPARTMENT OF MINES
OIL AND GAS DIVISION
CHARLESTON

WELL LOCATION MAP
FILE NO. WET-370-371 A
6 8

+ Denotes location of well on United States
Topographic Maps, scale 1 to 62,500, lat-
itude and longitude lines being represented
by border lines as shown.

- Denotes one inch spaces on border line
of original tracing.

PETER STARKEY NOS. 6 & 8 - SOUTH PENN NAT. GAS CO. - WET-370-A & 371-A

STATE OF WEST VIRGINIA
DEPARTMENT OF MINES
OIL AND GAS DIVISION

119

WELL RECORD

Permit No. 27-A


Oil or Gas Well OIL
(KIND)

Company South Penn Natural Gas Company,
Address Union Trust Bldg. Parkersburg, W. Va.
Farm Peter Starkey Acres 150
Location (waters) -----
Well No. 8 Elev. 1359.96
District Grant County Wetzel
The surface of tract is owned in fee by C. C. Bates
Address Folsom, W. Va.
Mineral rights are owned by Lafayette Starkey et al
Address Smithfield, W. Va.
Drilling commenced March 11, 1913
Drilling completed May 30, 1913
Date shot May 31-1913 20 ft of shot Gordon
May 20-1913 20 ft
Open Flow 10ths Water in --- Inch
10ths Merc. in --- Inch

Casing and Tubing	Used in Drilling	Left in Well	Packers
Size			
16			Kind of Packer <u>---</u>
13	<u>16'</u>		<u>---</u>
10	<u>232' (Pulled)</u>		Size of <u>---</u>
8 1/4	<u>1465'</u>		<u>---</u>
6 5/8	<u>2173'</u>		Depth set <u>---</u>
5 3/16	<u>2810'</u>		<u>---</u>
3			Perf. top <u>---</u>
2			Perf. bottom <u>---</u>
Liners Used			Perf. top <u>---</u>
			Perf. bottom <u>---</u>

Volume --- Cu. Ft. CASING CEMENTED SIZE --- No. Ft. --- Date ---
Rock Pressure --- lbs. --- ---
Oil 3 bbls., 1st 24 hrs. COAL WAS ENCOUNTERED AT 949 FEET 72 INCHES
Fresh water --- feet --- feet --- FEET --- INCHES --- FEET --- INCHES
Salt water 2533 feet --- feet --- FEET --- INCHES --- FEET --- INCHES

Formation	Color	Hard or Soft	Top	Bottom	Oil, Gas or Water	Depth Found	Remarks
Pittsburgh Coal			949	955			
Little Dunkard Sand			1222	1229			
Big Dunkard Sand			1322	1380	Gas	1224	
Gas Sand			1605	1635			
Salt Sand			1765	1909			
Maxon Sand			1970	2000			
Little Lime			2080	2098			
Big Lime			2158	2230			
Big Injun Sand			2230	2338			
Fifty Foot Sand			2808	2840	Water	2533	
Thirty Foot Sand			2924	2950			
Stray Sand			2977	3010			
Gordon Sand			3015	3039	Oil	3000	
Fourth Sand			3051		Oil	3030	
Total Depth				3088			

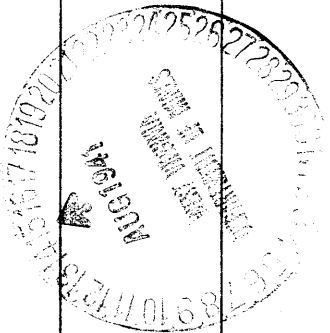

Formation	Color	Hard or Soft	Top	Bottom	Oil, Gas or Water	Depth Found	Remarks

Date August 13, 1941

APPROVED SOUTH PENN NATURAL GAS COMPANY, Owner

By Elton Elsen Land Agent.
(Title)

WELL RECORD

Oil or Gas Well

Permit No. _____
 Company: South Penn Natural Gas Company, Inc.
 Address: High Street Bldg. Parkersburg, W. Va.
 Farm: _____
 Location: _____
 District: _____
 The well is on tract owned or leased by: C. C. Hines
 Address: _____
 Mine: _____
 Drills: _____
 Date: _____
 Open: _____
 Cemented: _____
 Kind of Packer: _____
 State of: _____
 Depth set: _____
 Date: _____
 WAS ENCOUNTERED AT: 940 FEET 7 1/2 INCHES
 FEET INCHES
 FEET INCHES

Depth	Stratum	Hardness	Remarks
940	Big Blue Coal	25	
1222	Light Blue Sand	25	
1222	Dark Sand	25	
1222	Big Sand	25	
1222	Coal Sand	25	
1222	Big Sand	25	
1222	Light Blue	25	
1222	Big Blue	25	
1222	Big Blue Sand	25	
1222	Big Blue Sand	25	
2308	Fifty Foot Sand	25	
2924	Thirty Foot Sand	25	
2977	Stray Sand	25	
3013	Green Sand	25	
3051	Four Foot Sand	25	
3051	Total Depth	25	

AFFIDAVIT TO BE MADE BY THE WELL OPERATOR OR OPERATOR OR OWNER OF THE WELL

habins: roysom...
 The Fla...
 ADDRESS...
 OPERATOR OR OWNER...
 ADDRESS...
 C. C. ...
 OF PROPERTY OWNER...
 Fols...
 ADDRESS...
 STATE INSP... SUPERVISING PLUGGING...
 STATE OF VIRGINIA
 COUNTY OF...
 ... and Coy Guthrie
 being first sworn according to law and say that they are experienced in the work
 plugging and filling of oil and gas wells and were employed by South Penn Natural Gas C
 well operator and participated in the work of plugging and filling the above well, that said w
 was completed on the 20th day of August, 1941, and that the well was plug
 and filled as follows:

WELL NO.	DEPTH	PLUGGING MATERIAL		PIEGES USED		CASING
		CONCRETE	FEET	TO	SIZE & KIND	
4th Gordon	27	Clay	3088	2937	5-3/16" wood	2" tubing
		Cement	2954	2914		
39 7th	5	Clay	2944	2823	6-5/16" wood	
		Cement	2820	2810	5-5/16" wood	2 1/2"
Big Injan		Clay	8810	8186	5-3/16" wood	
		Cement	2183	2173		6-5/8" 1975'
E. L. Line	2	Clay	2173	1939	6-5/8" wood	
		Cement	1936	1926		
Self Sand		Clay	1926	1744	6-5/8" wood	
		Cement	1742	1732		
Permanent	30	Clay	1105	985	8-1/4" wood	982'
		Clay	1105	985		
		Clay	929	to surface		
COAL SEA						
NAME	Pittet	Cement	985	929	Cement 33"X33"X10" - ce	
NAME					in center, 3' high. Ina	
NAME					L. P. G. Co. - September -	
NAME						

and that the work of plugging and filling said well was completed on the 5th
 Sept 1941