

COAL OWNED BY BURTON COAL CO. UNIONTOWN PA.

- New Location...
- Drill Deeper.....
- Abandonment.....

AUG 25 1941

2.30 2.53 W
 4.81 4.42 R

Company THE MANUFACTURERS LIGHT & HEAT CO
 Address 800 UNION TRUST BLD'G. PITTSBURGH PA.
 Farm S. E. STEWART
 Tract _____ Acres 35A 95P Lease No. 4837
 Well (Farm) No. 2 Serial No. 2192
 Elevation (Spirit Level) 1078'
 Quadrangle MANNINGTON N.W.
 County WETZEL District CHURCH
 Engineer J. M. Mearns
 Engineer's Registration No. _____
 File No. _____ Drawing No. Y-10-258
 Date AUGUST 15 1941 Scale 1"=300'

STATE OF WEST VIRGINIA
 DEPARTMENT OF MINES
 OIL AND GAS DIVISION
 CHARLESTON

WELL LOCATION MAP
 File No. WET-372A

+ Denotes location of well on United States Topographic Maps, scale 1 to 62,500, latitude and longitude lines being represented by border lines as shown.

— Denotes one inch spaces on border line of original tracing.



S. E. STEWART No. 2 (2192) - MANUFACTURERS LIGHT & HEAT CO. - WET-372-A

STATE OF WEST VIRGINIA
DEPARTMENT OF MINES
OIL AND GAS DIVISION

860

WELL RECORD


Permit No. 71 A

Oil or Gas Well Gas
(KIND)

Company <u>The Mfrs Light & Heat Co.</u>	Casing and Tubing	Used in Drilling	Left in Well	Packers
Address <u>800 Union Trust Bldg., Pittsburgh, Pa.</u>	Size			
Farm <u>S. E. Stewart</u> Acres <u>37</u>	16			Kind of Packer
Location (waters)	13			
Well No. <u>1 - 2192</u> Elev. <u>1078 ft.</u>	10	<u>1002</u>		Size of
District <u>Church</u> County <u>Wetzel</u>	8 1/4	<u>1310</u>		Depth set
The surface of tract is owned in fee by <u>George Stewart</u>	6%	<u>2033' 6"</u>		
Address <u>Hundred, WVa.</u>	5 3/16			Perf. top
Mineral rights are owned by <u>The Mfrs Light & Heat Co.</u>	3			Perf. bottom
<u>800 Union Trust Bldg. Address Pittsburgh, Pa.</u>	2			Perf. top
Drilling commenced <u>Sept. 24, 1917</u>	Liners Used			Perf. bottom
Drilling completed <u>Dec. 13, 1917</u>				
Date shot _____ Depth of shot _____				
Open Flow /10ths Water in _____ Inch				
/10ths Merc. in _____ Inch				
Volume _____ Cu. Ft.	CASING CEMENTED	SIZE	No. Ft.	Date
Rock Pressure _____ lbs. _____ hrs.				
Oil _____ bbls., 1st 24 hrs.	COAL WAS ENCOUNTERED AT <u>492</u> FEET <u>48</u> INCHES			
Fresh water _____ feet _____ feet	<u>712</u> FEET <u>60</u> INCHES <u>827</u> FEET <u>84</u> INCHES			
Salt water _____ feet _____ feet	_____ FEET _____ INCHES _____ FEET _____ INCHES			

Formation	Color	Hard or Soft	Top	Bottom	Oil, Gas or Water	Depth Found	Remarks
Fairview Coal			492	496			Water at 90 ft.
Mapletown Coal			712	717			Little gas at 1365
Pittsburgh Coal			827	834			
Murphy Sand			1000	1015			
Little Dunkard			1210	1240			
Big Dunkard			1310	1345			
Gas Sand			1465	1480			
2nd Gas Sand			1485	1544			
1st Salt Sand			1575	1625	Gas 1595		
2nd Salt Sand			1625	1700	Gas 1630		
3rd Salt Sand			1740	1776			
Big Lime			1995	2052			
Big Injun			2052	2305			
50-Ft. Sand			2680	2700			
30-Foot Sand			2833	2855			
Gordon Stray			2865	2880	Gas 2873		
Gordon Stray			2890	2925			
4th Sand			2950	2970			
Slate & Shells			2970	2992			
5th Sand			2992	3009	Gas 3002		
Total depth				3057			

Formation	Color	Hard or Soft	Top	Bottom	Oil, Gas or Water	Depth Found	Remarks

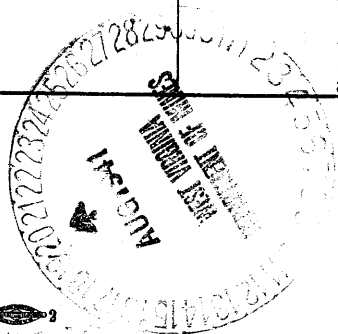

Date..... August 18th 1941

APPROVED THE MANUFACTURERS LIGHT & HEAT CO., Owner

By..... *HH Fowler*
 Land Dept. (Title) Office Mgr.
WB 701