

4174.23 W
 1.84 1.89 Q

JUN - 8 1942

New Location
 Drill Deeper
 Abandonment

Company CARNEGIE NATURAL GAS
 Address PITTSBURGH, PA.
 Farm G. W. THOMAS
 Tract Acres 127 Lease No. E-7423-72
 Well (Farm) No. 2 Serial No. E-679
 Elevation (Spirit Level) 1070
 Quadrangle MANNINGTON N.M.
 County WETZEL District CHURCH
 Engineer R.L. Sweeney
 Engineer's Registration No. _____
 File No. _____ Drawing No. _____

STATE OF WEST VIRGINIA
 DEPARTMENT OF MINES
 OIL AND GAS DIVISION
 CHARLESTON

WELL LOCATION MAP
 FILE NO. WET-414-A

+ Denotes location of well on United States Topographic Maps, scale 1 to 62,500, latitude and longitude lines being represented by border lines as shown.
 - Denotes one inch spaces on border line of original tracing.

WEST VIRGINIA DEPARTMENT OF MINES
OIL AND GAS DIVISION

886

WELL RECORD

Permit No.

Oil or Gas Well OIL
(Kind)

WELL TO BE ABANDONED

Company CARNEGIE NATURAL GAS COMPANY
Address 1014 FRICK BLDG., PITTSBURGH, PA.
Farm G. W. THOMAS Acres 127 1/2
Location (waters) STYLES RUN
Well No. 1-679 Elev. 1170
District CHURCH County WETZEL
The surface of tract is owned in fee by G. W. SOLE
Rt. #1, Address GLOVER GAP, W.VA.
Mineral rights are owned by SEE BELOW
Address

Drilling commenced October 2, 1916
Drilling completed January 28, 1917
Date shot Depth of shot

Open Flow /10ths Water in Inch
/10ths Merc. in Inch

Casing and Tubing	Used in Drilling	Left in Well	Packers
Size			
16.....			Kind of Packer.....
13.....			
10.....		<u>144'</u>	Size of.....
8 1/4.....			
6 5/8.....		<u>1660'</u>	Depth set.....
5 3/16.....		<u>2129'</u>	
3.....			Perf. top.....
2.....		<u>3125'</u>	Perf. bottom.....
Liners Used.....	<u>4"</u>	<u>762'</u>	Perf. top.....
			Perf. bottom.....

Volume Cu. Ft. CASING CEMENTED..... SIZE..... No. FT..... Date

Rock Pressure lbs. hrs.

Oil bbls., 1st 24 hrs. COAL WAS ENCOUNTERED AT 797 FEET..... INCHES


Fresh water feet feet 900 FEET..... FEET..... INCHES

Salt water feet feet FEET..... INCHES..... FEET..... INCHES

Formation	Color	Hard or Soft	Top	Bottom	Oil Gas or Water	Depth Found	Remarks
Mapleton Coal			797'	801'			
Pittsburgh Coal			900	908			
Big Dunkard			1390	1420			
Gas Sand			1535	1565			
1st Salt Sand			1650	1720			
2nd Salt Sand			1780	1900			
Little Lime			2061	2074			
Pencil Cave			2074	2080			
Big Lime			2080	2132			
Big Injun			2132	2357			
50-Foot			2860	2875			
Gordon Stray			2994	3009	Gas	3002-3006	
Gordon Sand			3032	3077			
Fifth Sand			3110	3125	Oil	3113-3116	Break 3064-3067
TOTAL DEPTH				3125			

OWNERS of MINERAL RIGHTS

U. G. Thomas,	Hundred, W. Va.
John Thomas,	Rt. 2, Barnsville, Ohio
Mrs. Mary Barr,	Morristown, Ohio
G. L. Thomas,	Floreville, Texas
Mrs. Flora Snyder,	Cameron, W. Va.
Edward Thomas,	Cambridge, Ohio
Mrs. Lillian Garner,	Hundred, W. Va.
Ida Thomas,	Cameron, W. Va.

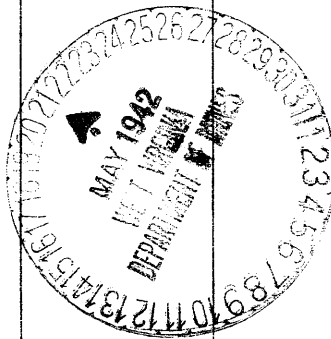

Formation	Color	Hard or Soft	Top	Bottom	Oil, Gas or Water	Depth Found	Remarks

Date..... **May 20,**, 19**42**.

APPROVED..... **CARNEGIE NATURAL GAS COMPANY**, Owner

By..... *D. H. Archer*,
(Title) **land Agent.**