


Latitude 39° 45'

Longitude 80° 30'

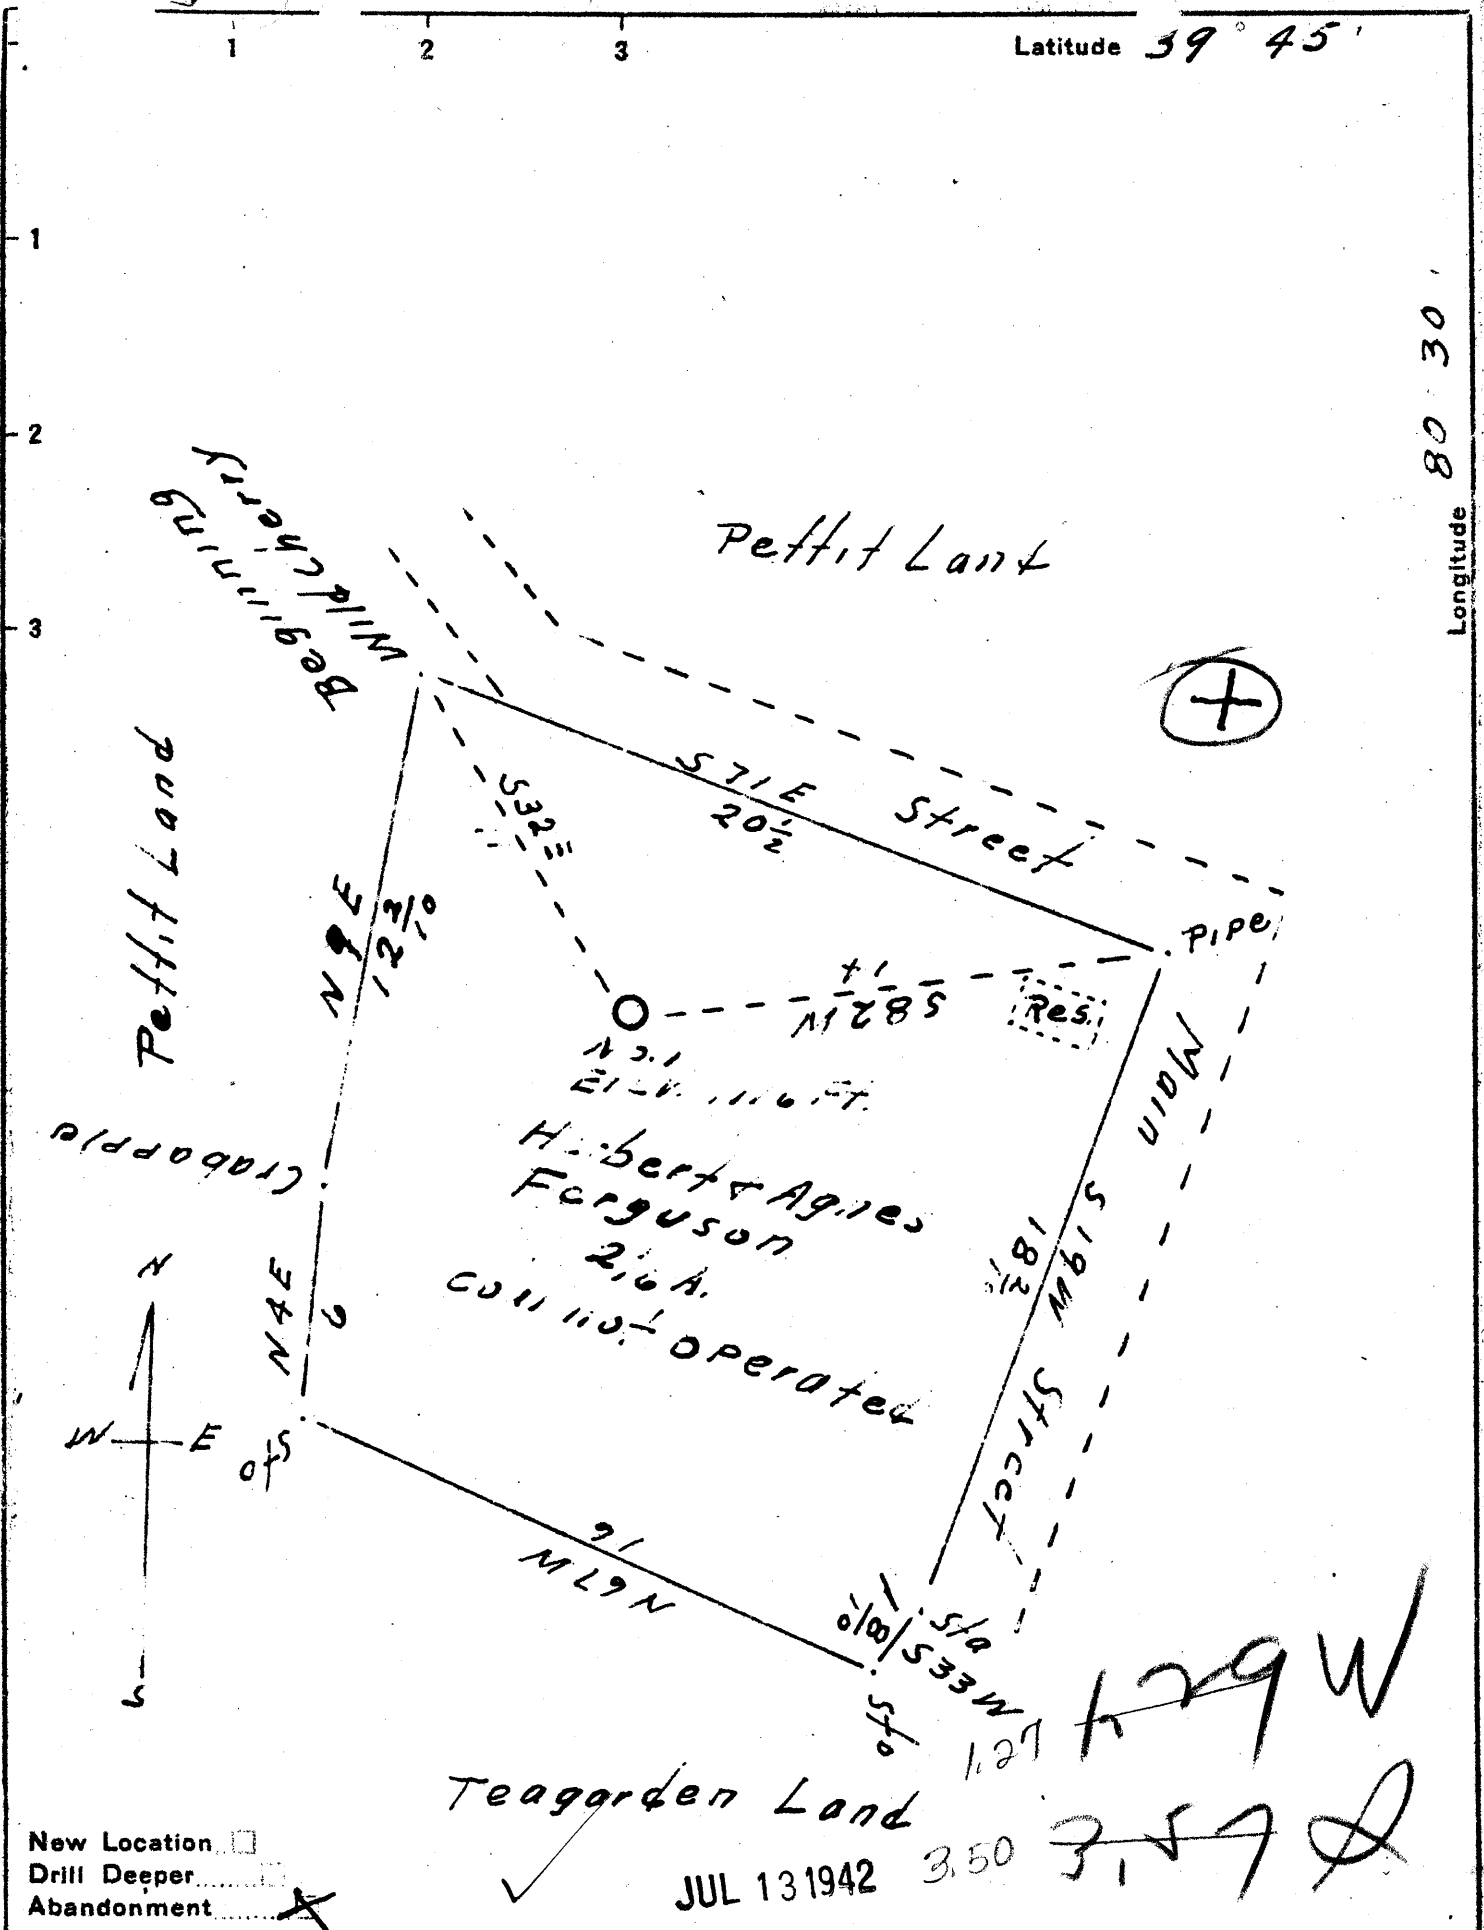

New Location   
 Drill Deeper   
 Abandonment

JUL 13 1942

129 W  
 3.57

Company Interstate Pipe & Supply Co.  
 Address Marretta Ohio  
 Farm H. & A. Ferguson  
 Tract \_\_\_\_\_ Acres 2 1/6 Lease No. \_\_\_\_\_  
 Well (Farm) No. One Serial No. \_\_\_\_\_  
 Elevation (Spirit Level) 1116 Feet  
 Quadrangle Littleton  
 County Wetzel District Clay  
 Engineer J. M. Cochran  
 Engineer's Registration No. Co. Surveyor  
 File No. \_\_\_\_\_ Drawing No. \_\_\_\_\_  
 Date July 3 1942 Scale 1" = 5 Rods

STATE OF WEST VIRGINIA  
 DEPARTMENT OF MINES  
 OIL AND GAS DIVISION  
 CHARLESTON

WELL LOCATION MAP  
 FILE NO. Wet 417 A

+ Denotes location of well on United States Topographic Maps, scale 1 to 62,500, latitude and longitude lines being represented by border lines as shown.  
 - Denotes one inch spaces on border line of original tracing.