

39°40'00"

Latitude

80°25'00"

7 1/2

+ .625
.33w

Longitude


Topo Location

7.5' Loc. _____ 15' Loc. _____
_____ (calc.) _____

Company Maxton Oil & Gas Co
Farm J D Bartevg #1
15' Quad _____
(sec.) _____
7.5' Quad Hundred
District Church

WELL LOCATION PLAT

County 103 Permit 30916
Now
429A

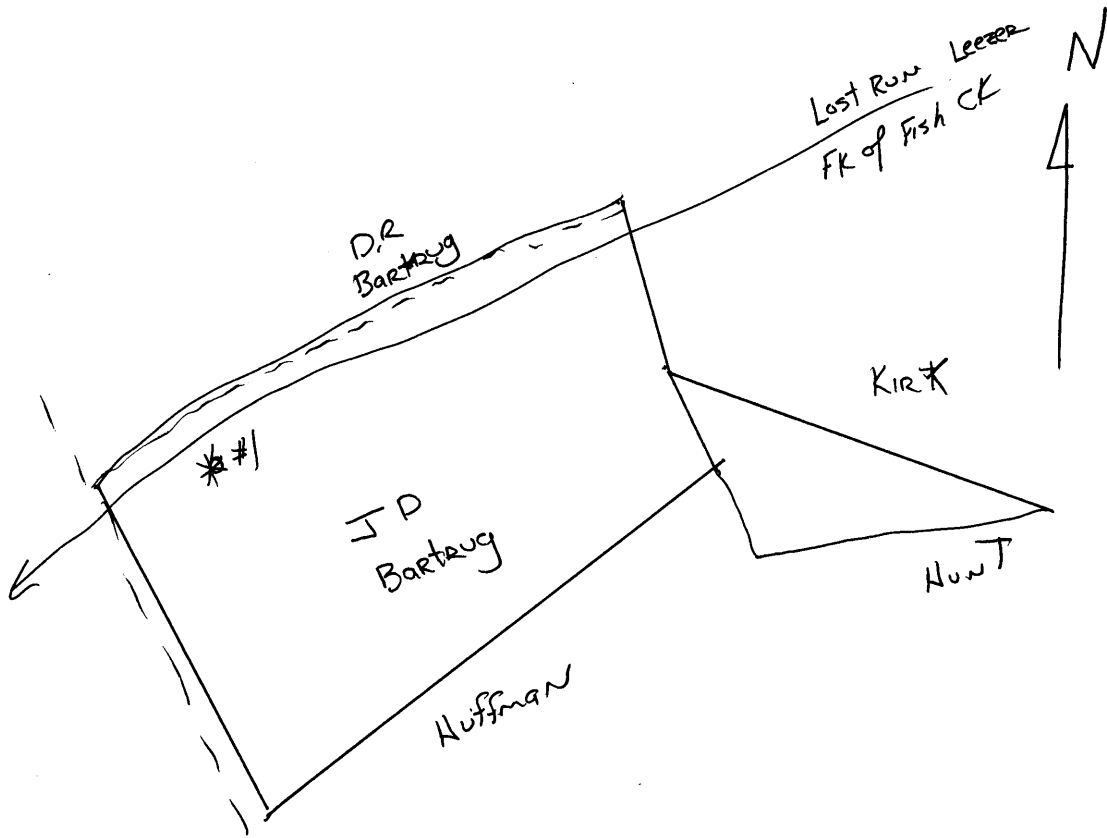



1342

STATE OF WEST VIRGINIA
DEPARTMENT OF MINES
OIL AND GAS DIVISION

WELL RECORD

Ab 916-A

Permit No. _____ Oil or Gas Well Oil (KIND)


Company Maxton Oil & Gas Co.
 Address Fairmont, W. Va.
 Farm J. D. Bartrug Acres 38 1/2
 Location (waters) Leezer Fork of Fishing Creek
 Well No. 1 Elev. 1105 ft.
 District Church County Netzel
 The surface of tract is owned in fee by N. C. Park
 Address Blue Creek, W. Va.
 Mineral rights are owned by Essie Lewis Bartrug
 Address Fairmont, W. Va.
 Drilling commenced July 1919
 Drilling completed Sept. 16th, 1919.
 Date Shot _____ From _____ To _____
 With _____
 Open Flow _____ /10ths Water in _____ Inch
 _____ /10ths Merc. in _____ Inch
 Volume _____ Cu. Ft.
 Rock Pressure _____ lbs. _____ hrs.
 Oil 3 bbl. _____ bbls., 1st 24 hrs.
 Fresh water _____ feet _____ feet
 Salt water _____ feet _____ feet

Casing and Tubing	Used in Drilling	Left in Well	Packers
Size			
16			Kind of Packer
13			<u>None</u>
10 240 ft.		240 ft.	Size of
8 1/2 1306 ft.		1306 ft.	
6 5/8 1906 ft.		1906 ft.	Depth set
5 3/16			
3			Perf. top
2			Perf. bottom
Liners Used		214 ft.	Perf. top
			Perf. bottom

CASING CEMENTED No SIZE _____ No. Ft. _____ Date _____

COAL WAS ENCOUNTERED AT 913 FEET _____ INCHES
 _____ FEET _____ INCHES FEET _____ INCHES
 _____ FEET _____ INCHES FEET _____ INCHES

Formation	Color	Hard or Soft	Top	Bottom	Oil, Gas or Water	Depth Found	Remarks
Pittsburg							
Coal			933 ft.	919 ft.			
Little Dunkard			1320 ft.	1372 ft.			
Big Dunkard			1395 ft.	1445 ft.			
Gas Sand			1495 ft.	1515 ft.			
1st salt sand			1592 ft.	1627 ft.			
2nd salt sand			1725 ft.	1805 ft.			
3rd salt sand			1850 ft.	1928 ft.			
Maxton sand			2028 ft.	2092 ft.			
Dark Break			2028 ft.	2069 ft.			
Oil			2078 ft.	2080 ft.			
Total depth			2085 ft.	2092 ft.			

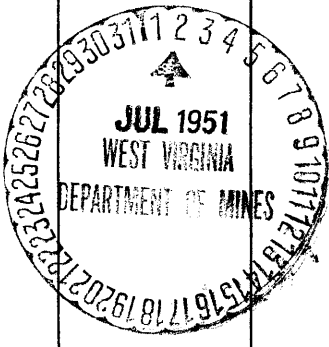

(Over) AUG 27 1951

Formation	Color	Hard or Soft	Top	Bottom	Oil, Gas or Water	Depth Found	Remarks

Date _____, 19____

APPROVED _____, Owner

By _____ (Title)