

plugged 10/20/43
 New Location
 Drill Deeper
 Abandonment

✓ JUN - 1 1943
 2.14 7.18 W
 2.14 7.18 O
 N13-14 E1 Map N78

Company South Penn Natural Gas Co.
 Address Parkersburg, W. Va.
 Farm Peter Postlethwaite
 Tract _____ Acres 80 Lease No. 40137
 Well (Farm) No. 3 Serial No. _____
 Elevation (Spirit Level) 1345.00
 Quadrangle Littleton
 County Wetzel District Center
 Engineer Emmon Haines
 Engineer's Registration No. _____
 File No. _____ Drawing No. _____
 Date 4-27-43 Scale 1"=400'

STATE OF WEST VIRGINIA
 DEPARTMENT OF MINES
 OIL AND GAS DIVISION
 CHARLESTON

WELL LOCATION MAP
 FILE NO. WET-445-A

+ Denotes location of well on United States Topographic Maps, scale 1 to 62,500, latitude and longitude lines being represented by border lines as shown.
 - Denotes one inch spaces on border line of original tracing.

STATE OF WEST VIRGINIA
DEPARTMENT OF MINES
OIL AND GAS DIVISION

903

WELL RECORD

Permit No. 445-1A

Oil or Gas Well: OIL
(KIND)

Company: South Penn Natural Gas Company
 Address: Union Trust Bldg. Parkersburg, W. Va.
 Farm: Peter Postlethwaite Acres: 80
 Location (waters):
 Well No. 3 Elev. 1345.
 District: Center County: Wetzel
 The surface of tract is owned in fee by Peter Postlethwaite
 Heirs, c/o Richard Endicott, W. Va.
 Mineral rights are owned by Peter Postlethwaite Hrs.
 c/o R.L. Postlethwaite, Address: Dean, W. Va.
 Drilling commenced: Dec. 9, 1903
 Drilling completed: March 13, 1904
 Date Shot: 2-15-04 - 30 qt. Stray
 With: ---


Casing and Tubing	Used in Drilling	Left in Well	Packers
Size			
16.			Kind of Packer: -
13.			
10.	804' (Pulled)		Size of: -
8 1/4.	1645' (Pulled 929')		
6%.	2019'		Depth set: -
5 3/16.	2440'		
3.			Perf. top: -
2.			Perf. bottom: -
Liners Used:			Perf. top: -
Cond.	16'		Perf. bottom: -

Open Flow /10ths Water in: --- Inch
 /10ths Merc. in: --- Inch
 Volume: --- Cu. Ft.
 Rock Pressure: --- lbs. --- hrs.
 Oil: 20 bbls., 1st 24 hrs.
 Fresh water: --- feet --- feet
 Salt water: 1950 feet --- feet

CASING CEMENTED: --- SIZE: --- No. Ft.: --- Date: ---
 COAL WAS ENCOUNTERED AT 1230 FEET 96 INCHES
 --- FEET --- INCHES --- FEET --- INCHES
 --- FEET --- INCHES --- FEET --- INCHES

Formation	Color	Hard or Soft	Top	Bottom	Oil, Gas or Water	Depth Found	Remarks
Pittsburgh Coal			1230	1238	Water	1950	
Dunkard Sand			1930	2130			
Maxon Sand			2360	2375			
Pencil Cave			2375	2385			
Big Lime			2385	2445			
Big Injun			2445	2680	Oil & Gas	3289	
Stray Sand			3265				
Gordon			3301				
Total Depth				3310			

(Office Well Record does not show Salt Sand).

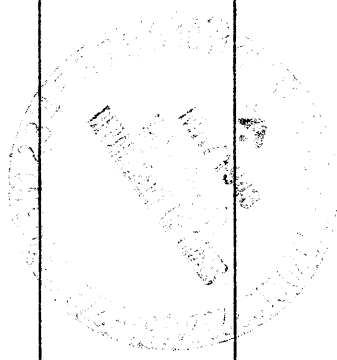

Formation	Color	Hard or Soft	Top	Bottom	Oil, Gas or Water	Depth Found	Remarks

Date **May 13, 1943.**, 194

APPROVED **SOUTH PENN NATURAL GAS COMPANY,** Owner

By *Eaton Young* Land Agent.
(Title)