

0

1

2

3

LATITUDE

45

1

2

3

25

60

LONGITUDE

PATRICK TAYLOR

GEO. RENNER

J. M. MORFORD

STONE

292 P

STONE COR

400

S. 88 1/2 W.

STONE

N 1/2 E 18 P

STONE

WELL 6 - (574)
ELEV - 1365

DAVID HOSTUTLER
NOW
GRAVE LAMBERT
150 AC.

N. 43 3/4 E 15.2 P.
HICKORY

N. 34 E. 28 1/4 P.

STONE
N. 20 E 28 P.

7925 P
STONE

S. 69 E.

116.5 P

N. 61 3/4 E 32 P.
STONE

W. E. JOHNSON

W. J. SNYDER

COAL OWNED BY LE ROY JOHNSON, WADESTOWN W. VA.

WELL LOCATION
DRILL DEEPER
ABANDONMENT

0.48 0.15 W

JUN - 2 1944 2.08 FHQ

COMPANY NATIONAL SUPPLY COMPANY
 ADDRESS LOGAN OHIO.
 NAME DAVID HOSTUTLER
 TRACT ACRES 150 LEASE NO.
 WELL (FARM) NO. 2 SERIAL NO. 6 - (574)
 ELEVATION (SPIRIT LEVEL) 1365
 TOWNSHIP MANNINGTON
 COUNTY WETZEL DISTRICT CHURCH
 ENGINEER *J. C. Menden*
 ENGINEER'S REGISTRATION NO.
 DRAWING NO. U-1-265 (N)
 DATE MARCH 23 1944 SCALE 1"=800'

STATE OF WEST VIRGINIA
 DEPARTMENT OF MINES
 OIL AND GAS DIVISION
 CHARLESTON

WELL LOCATION MAP
 FILE NO. WET-471-A

INDICATES LOCATION OF WELL ON UNITED STATES TOPOGRAPHIC MAPS, SCALE 1 TO 62,500. LATITUDE AND LONGITUDE LINES BEING REPRESENTED BY BORDER LINES AS SHOWN.

INDICATES ONE INCH SPACES ON BORDER LINE OF ORIGINAL DRAWING.

DAVID HOSTUTLER No 2 (6) (574) - NATIONAL SUPPLY CO. - WET-471-A



935

STATE OF WEST VIRGINIA
DEPARTMENT OF MINES
OIL AND GAS DIVISION

WELL RECORD

Permit No. 471-A Oil or Gas Well Oil
(KIND)


Company National Supply Company
Address Logan, Ohio
Farm David Hostutler Acres 1.90
Location (waters) _____
Well No. 6-574 Elev. 1365 ft.
District Church County Wetzel
The surface of tract is owned in fee by Alma Hostutler
Address Sundrad, E. Va.
Mineral rights are owned by National Supply Company
Address Logan, Ohio
Drilling commenced June 1, 1926
Drilling completed July 1, 1926
Date Shot Sept. 4, 1926 from 3085 To 3091
With 20 lbs & 9/8/26 from 3051 to 3057 - 20 lbs.

Casing and Tubing	Used in Drilling	Left in Well	Packers
Size			
16			Kind of Packer
13			
10	202	202	Size of
8 1/4	1456	1456	
6 1/2	2240	2240	Depth set
5 3/16			
3			Perf. top
2			Perf. bottom
Liners Used			Perf. top
			Perf. bottom

Open Flow /10ths Water in _____ Inch
/10ths Merc. in _____ Inch
Volume _____ Cu. Ft.
Rock Pressure _____ lbs. _____ hrs.
Oil _____ bbls., 1st 24 hrs.
Fresh water _____ feet _____ feet
Salt water _____ feet _____ feet

CASING CEMENTED _____ SIZE _____ No. Ft. _____ Date _____
COAL WAS ENCOUNTERED AT 686 FEET 48 INCHES
905 FEET 60 INCHES 1017 FEET 96 INCHES
_____ FEET _____ INCHES _____ FEET _____ INCHES

Formation	Color	Hard or Soft	Top	Bottom	Oil, Gas or Water	Depth Found	Remarks
Fairview Coal			686	690			
Mapletown "			905	910			
Pittsburgh Coal			1017	1025			
Maxon Sand			2109	2175	Gas 2120 - 2124		
Big Injun			2233	2475			
50 Foot Sand			2978	2984			
30 Foot Sand			3007	3073			
Stray			3077	3098			
Gordon Sand			3133	3185			
Fourth Sand			3214	3233			
Total Depth				3246			

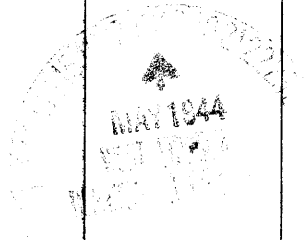

Formation	Color	Hard or Soft	Top	Bottom	Oil, Gas or Water	Depth Found	Remarks

Date May 17, 1944

APPROVED The National Supply Company, Owner

By *R. Hallum, Sgt.*
(Title)

