

New Location
 Drill Deeper
 Abandonment

✓ 1.54 + JFW
 NOV - 5 1944
 4,69
 4,74 X

Company E.H. Jennings Bros. Co.
 Address 2009 Clark Bldg. Pittsburgh, Pa.
 Farm Hiram Carney
 Tract _____ Acres 123 Lease No. _____
 Well (Farm) No. 1 Serial No. _____
 Elevation (Spirit Level) 983
 Quadrangle Littleton
 County Wetzel District Center
 Engineer A.K. Whitfall
 Engineer's Registration No. Surveyor, Ritchie, Co.
 File No. _____ Drawing No. _____
 Date Oct. 4, 1944 Scale 1" = 40 Poles


STATE OF WEST VIRGINIA
 DEPARTMENT OF MINES
 OIL AND GAS DIVISION
 CHARLESTON

WELL LOCATION MAP
 FILE NO. WET-484-A

+ Denotes location of well on United States Topographic Maps, scale 1 to 62,500, latitude and longitude lines being represented by border lines as shown.
 - Denotes one inch spaces on border line of original tracing.



STATE OF WEST VIRGINIA
DEPARTMENT OF MINES
OIL AND GAS DIVISION

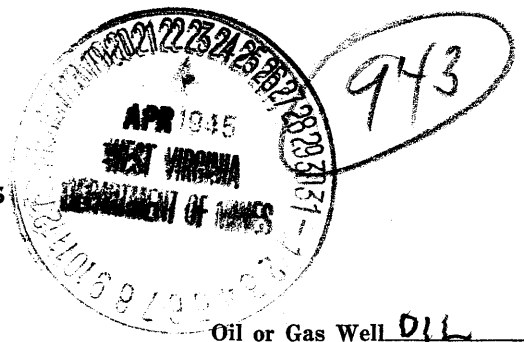

484-A

WELL RECORD


Permit No. _____ Oil or Gas Well OIL (KIND)

Company E. H. Jennings Bros. Co.
Address 2009 Clark Bldg., Pittsburgh 22, Pa.
Farm Niram Carney Acres 127
Location (waters) _____
Well No. 1 Elev. 983
District Center County Wetzel
The surface of tract is owned in fee by _____
Address _____
Mineral rights are owned by E.H. Jennings Bros. Co.
2009 Clark Bldg., Pittsburgh 22, Pa. Address _____
Drilling commenced Spudding started 3-2-1900
Drilling completed 3-14-1901
Date Shot 3-1-1901 From _____ To _____
With 60 Qts.
Open Flow _____ /10ths Water in _____ Inch
_____ /10ths Merc. in _____ Inch
Volume _____ Cu. Ft.
Rock Pressure _____ lbs. _____ hrs.
Oil _____ bbls., 1st 24 hrs.
Fresh water _____ feet _____ feet
Salt water _____ feet _____ feet

Casing and Tubing	Used in Drilling	Left in Well	Packers
Size			Kind of Packer
16			
13			
10	400	0	Size of
8 1/4	1090	508	
6 5/8	1830	1830	Depth set
5 3/16	2151	2151	
3			Perf. top
2			Perf. bottom
Liners Used			Perf. top
			Perf. bottom

CASING CEMENTED _____ SIZE _____ No. Ft. _____ Date _____
COAL WAS ENCOUNTERED AT _____ FEET _____ INCHES
_____ FEET _____ INCHES FEET _____ INCHES
_____ FEET _____ INCHES FEET _____ INCHES

Formation	Color	Hard or Soft	Top	Bottom	Oil, Gas or Water	Depth Found	Remarks
Pgh. Coal			980				
Top Injun			2192				
Bottom Injun				2398			
Top Gordon			3007				
Pay			3021				
Bottom Gordon			3034				
Total				3037			

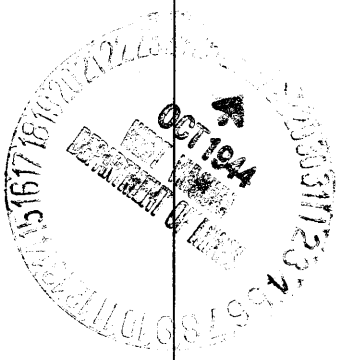

Formation	Color	Hard or Soft	Top	Bottom	Oil, Gas or Water	Depth Found	Remarks

Date 10-25, 1944

APPROVED E. H. JENNINGS BROS. CO., Owner

By *E. H. Jennings*
(Title) President

