


Jake Long

I. Jolliff

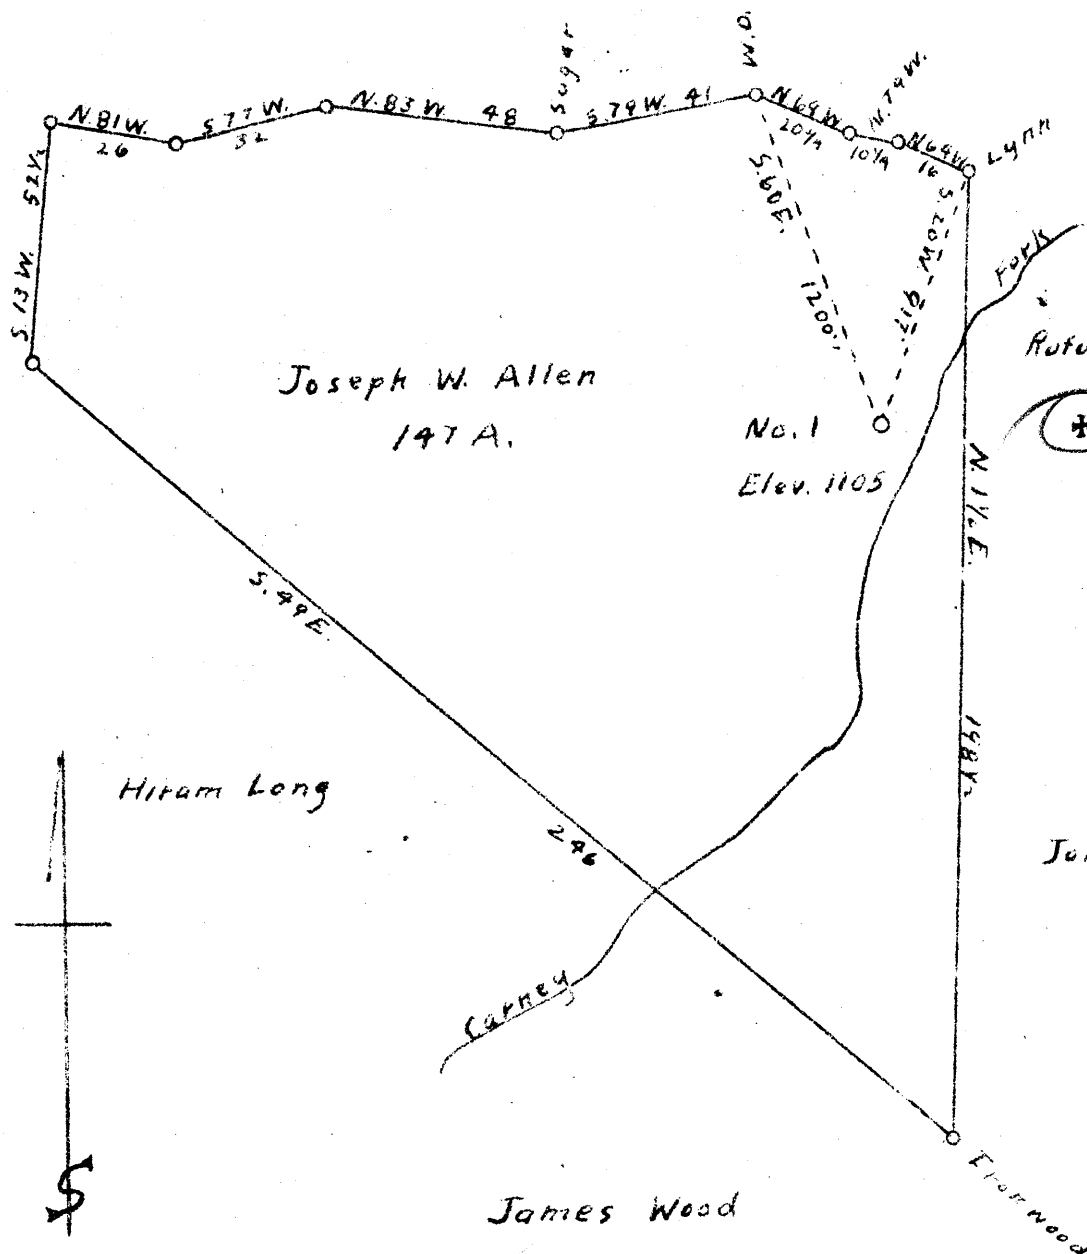

NOV 21 1944

289 29 ~~2~~

439 447 ~~2~~

- New Location
- Drill Deeper
- Abandonment

Company E. H. Jennings Bros. Co.

Address 2009 Clark Bldg. Pittsburgh, Pa.

Farm Joseph W. Allen

Tract _____ Acres 197 Lease No. _____

Well (Farm) No. 1 Serial No. _____

Elevation (Spirit Level) 1105

Quadrangle Littleton

County Wetzel District Center

Engineer A. K. Westfall

Engineer's Registration No. Surveyor, Ritchie, Co.

File No. _____ Drawing No. _____

Date Oct. 4, 1944 Scale 1" = 40 Poles

NO

STATE OF WEST VIRGINIA
DEPARTMENT OF MINES
OIL AND GAS DIVISION
CHARLESTON

WELL LOCATION MAP
FILE NO. Wet-485-A

- + Denotes location of well on United States Topographic Maps, scale 1 to 62,500. latitude and longitude lines being represented by border lines as shown.
- Denotes one inch spaces on border line of original tracing.



STATE OF WEST VIRGINIA
DEPARTMENT OF MINES
OIL AND GAS DIVISION

960

WELL RECORD

Permit No. Ab 485 A Oil or Gas Well X (KIND)

Company E. H. Jennings Bros. Co.
Address 2009 Clark Bldg., Pittsburgh 22, Pa.
Farm Joseph W. Allen Acres 120
Location (waters) Rocky Run
Well No. 1 Elev. 1105
District Center County Wetzel
The surface of tract is owned in fee by _____
Address _____
Mineral rights are owned by E.H. Jennings Bros. Co.
2009 Clark Bldg.
Address Pittsburgh, Pa.
Drilling commenced _____
Drilling completed Aug. 9, 1900
Date Shot 11-6-1929 From _____ To _____
With 60 Quarts
Open Flow _____ /10ths Water in _____ Inch
_____ /10ths Merc. in _____ Inch
Volume _____ Cu. Ft.
Rock Pressure _____ lbs. _____ hrs.
Oil _____ bbls., 1st 24 hrs.
Fresh water _____ feet _____ feet
Salt water _____ feet _____ feet

Casing and Tubing	Used in Drilling	Left in Well	Packers
Size			
16			Kind of Packer
13			
10	410'	410'	Size of
8 1/4	1498'	1498'	
6 1/2	2191'	2191'	Depth set
5 3/16			
3			Perf. top
2			Perf. bottom
Liners Used			Perf. top
			Perf. bottom

CASING CEMENTED _____ SIZE _____ No. Ft. _____ Date _____
COAL WAS ENCOUNTERED AT _____ FEET _____ INCHES
_____ FEET _____ INCHES FEET _____ INCHES
_____ FEET _____ INCHES FEET _____ INCHES

Formation	Color	Hard or Soft	Top	Bottom	Oil, Gas or Water	Depth Found	Remarks
Pgh. Coal			1044				
Indian			2250	2475			
Indian			2343		Gas		
Gordon			3079				
Pay			3089				
Total				3104			

9

OCT 1944
DEPARTMENT OF MINES

