

Company CARNEGIE NATURAL GAS  
 Address PITTSBURGH, PENNA.  
 Farm JOHN BOOTH  
 Tract ONE Acres 73 1/2 Lease No. E-2837-12  
 Well (Farm) No. 1 Serial No. 15  
 Elevation (Spirit Level) 1245'  
 Quadrangle MANNINGTON N.W. 14  
 County WETZEL District CHURCH  
 Engineer D.T. BRITTON  
 Engineer's Registration No. \_\_\_\_\_  
 File No. \_\_\_\_\_ Drawing No. \_\_\_\_\_  
 Date 2-9-1945 Scale 1" = 20 POLES

STATE OF WEST VIRGINIA  
 DEPARTMENT OF MINES  
 OIL AND GAS DIVISION  
 CHARLESTON

WELL LOCATION MAP  
 FILE NO. WET-495-A

+ Denotes location of well on United States Topographic Maps, scale 1 to 62,500, latitude and longitude lines being represented by border lines as shown.  
 - Denotes one inch spaces on border of original tracing.

JOHN BOOTH NO. 1 (N) - CARNEGIE OIL CO. - WET-495-A



940

STATE OF WEST VIRGINIA  
DEPARTMENT OF MINES  
OIL AND GAS DIVISION

**WELL RECORD**  
WELL TO BE ABANDONED

Permit No. **495-A**


Oil or Gas Well **GAS**  
(KIND)

Company **CARNEGIE NATURAL GAS COMPANY**  
Address **1015 FRICK BLDG., PITTSBURGH, PA.**  
Farm **JOHN BOOTH** Acres **5**  
Location (waters) \_\_\_\_\_  
Well No. **15** Elev. **1215'**  
District **CHURCH** County **WETZEL**  
The surface of tract is owned in fee by **W. G. BOOTH**  
Address **HUNDRED, W. VA.**  
Mineral rights are owned by **SEE BELOW**  
Address \_\_\_\_\_  
Drilling commenced **7-22-08**  
Drilling completed **9-30-08**  
Date Shot \_\_\_\_\_ From \_\_\_\_\_ To \_\_\_\_\_  
With \_\_\_\_\_  
Open Flow \_\_\_\_\_ /10ths Water in \_\_\_\_\_ Inch  
\_\_\_\_\_ /10ths Merc. in \_\_\_\_\_ Inch  
Volume **184,000** Cu. Ft.  
Rock Pressure **585** lbs. **24** hrs.  
Oil \_\_\_\_\_ bbls., 1st 24 hrs.  
Fresh water \_\_\_\_\_ feet  
Salt water \_\_\_\_\_ feet

Casing and Tubing	Used in Drilling	Left in Well	Packers
Size			
16			Kind of Packer
18			
10	<b>273'</b>	<b>273'</b>	Size of
8 1/4	<b>1353'</b>	<b>1353'</b>	
6 3/4	<b>2125'</b>	<b>2125'</b>	Depth set
5 3/16			
3			Perf. top
2			Perf. bottom
Liners Used			Perf. top
			Perf. bottom

CASING CEMENTED \_\_\_\_\_ SIZE \_\_\_\_\_ No. Ft. \_\_\_\_\_ Date \_\_\_\_\_  
COAL WAS ENCOUNTERED AT **852** FEET \_\_\_\_\_ INCHES  
**961** FEET \_\_\_\_\_ INCHES FEET \_\_\_\_\_ INCHES  
\_\_\_\_\_ FEET \_\_\_\_\_ INCHES FEET \_\_\_\_\_ INCHES

Formation	Color	Hard or Soft	Top	Bottom	Oil, Gas or Water	Depth Found	Remarks
Mapletown Coal			<b>852'</b>	<b>859'</b>			
Pittsburgh Coal			<b>961</b>	<b>968</b>			
Big Injun Sand			<b>2275</b>	<b>2301</b>			
50-Foot Sand			<b>2880</b>	<b>2900</b>			
30-Foot Sand			<b>2955</b>	<b>2975</b>			
Gordon Stray			<b>2975</b>				
Gordon Sand			<b>2990</b>	<b>3060</b>			
4th Sand			<b>3080</b>	<b>3100</b>			
5th Sand			<b>3182</b>		<b>Gas at</b>	<b>3132'</b>	
<b>TOTAL DEPTH</b>				<b>3226'</b>			

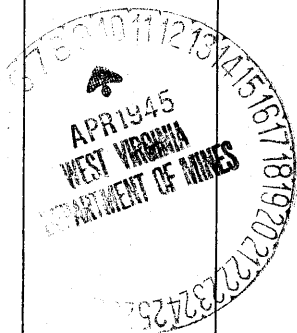

OWNERS of MINERAL RIGHTS:

Nancy C. Carman, Delilah S. Longstreth, George Booth, William G. Booth, Charles D. Booth, Edna L. Murphy,	Burton, W. Va. 203 Franklin St., Mannington, W.Va. Hundred, W. Va. Hundred, W. Va. Hundred, W. Va. Littleton, W.Va.
--	--

FEB 1945

2125  
1353  
273

Formation	Color	Hard or Soft	Top	Bottom	Oil, Gas or Water	Depth Found	Remarks

Date **FEBRUARY 19**, 194**5**

APPROVED **CARNEGIE NATURAL GAS COMPANY**, Owner

By *Carroll Lanning*  
(Title) **Gen. Supt.**