

New Location...
 Drill Deeper...
 Abandonment

2.89 2.91 W
 5.60 5.7 Q
 OCT - 9 1945

Company CARNEGIE NATURAL GAS
 Address PITTSBURGH, PENNA.
 Farm MARY A. VANHORN
 Tract ONE Acres 2.5 Lease No. E-923772
 Well (Farm) No. 1 Serial No. 573
 Elevation (Spirit Level) 1305'
 Quadrangle MANNINGTON NW 1/4
 County WETZEL District CHURCH
 Engineer D.T. BRITTON
 Engineer's Registration No. _____
 File No. _____ Drawing No. _____
 Date 4-14-1945 Scale 1" = 400'

STATE OF WEST VIRGINIA
 DEPARTMENT OF MINES
 OIL AND GAS DIVISION
 CHARLESTON

WELL LOCATION MAP
 FILE NO. WET-507-A

+ Denotes location of well on United States Topographic Maps, scale 1 to 62,500, latitude and longitude lines being represented by border lines as shown.

- Denotes one inch spaces on border line original tracing.

WEST VIRGINIA DEPARTMENT OF MINES
OIL AND GAS DIVISION

972

WELL RECORD

AP 507-A

Permit No. _____

Oil or Gas Well GAS
(Kind)


WELL TO BE ABANDONED

Company CARNEGIE NATURAL GAS COMPANY
 Address 1015 Frick Bldg., PITTSBURGH, PA.
 Farm MARY A. VANHORN Acres 25
 Location (waters) BURNER RUN
 Well No. 573 Elev. 1305
 District CHURCH County NETZEL
 The surface of tract is owned in fee by JENNIE HOSTUTLER
 Address HUNDRED, W. VA.
 Mineral rights are owned by MARY A. VANHORN
 Address CLARKSBURG, W.VA.
 Drilling commenced 4-27-16
 Drilling completed 6-15-16
 Date shot _____ Depth of shot _____
 Open Flow /10ths Water in _____ Inch
 /10ths Merc. in _____ Inch
 Volume 554,000 Cu. Ft.
 Rock Pressure 820 lbs. _____ hrs.
 Oil _____ bbls., 1st 24 hrs.
 Fresh water _____ feet _____ feet
 Salt water _____ feet _____ feet

| Casing and Tubing | Used in Drilling | Left in Well | Packers |
|-------------------|------------------|--------------|----------------|
| Size | | | Kind of Packer |
| 16 | | | |
| 13 | | | |
| 10 | 197' | 197' | Size of |
| 8 1/4 | 1522 | 962 | |
| 6 5/8 | 2239 | 2230 | Depth set |
| 5 3/16 | | | |
| 3 | | | Perf. top |
| 2 | | | Perf. bottom |
| Liners Used | | | Perf. top |
| | | | Perf. bottom |

CASING CEMENTED _____ SIZE _____ No. FT. _____ Date _____
 COAL WAS ENCOUNTERED AT 1028 FEET _____ INCHES
 _____ FEET _____ INCHES _____ FEET _____ INCHES
 _____ FEET _____ INCHES _____ FEET _____ INCHES

| Formation | Color | Hard or Soft | Top | Bottom | Oil Gas or Water | Depth Found | Remarks |
|-----------------|-------|--------------|------|--------|------------------|-------------|---------|
| Pittsburgh Coal | | | 1028 | 1036 | | | |
| Little Dunkard | | | 1430 | 1442 | | | |
| Big Dunkard | | | 1520 | 1555 | | | |
| Gas Sand | | | 1700 | 1777 | | | |
| 1st Salt Sand | | | 1770 | 1815 | | | |
| 2nd Salt Sand | | | 1835 | 1900 | | | |
| 3rd Salt Sand | | | 1960 | 2038 | | | |
| Morton Sand | | | 2174 | 2194 | | | |
| Fennell Cave | | | 2194 | 2204 | | | |
| Big Line | | | 2204 | 2254 | Show Gas | 2269' | |
| Big Injun | | | 2254 | 2502 | Gas | 2356' | |
| 50-Foot Sand | | | 3018 | 3037 | | | |
| Gordon Stray | | | 3057 | 3086 | | | |
| Gordon Sand | | | 3100 | 3127 | Show Oil | 3194' | |
| 4th Sand | | | 3162 | 3208 | Gas | 3202' | |
| TOTAL DEPTH | | | | 3360' | | | |

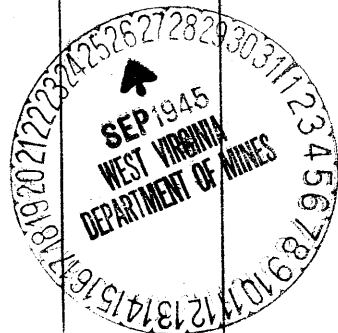

(Over)

DEC - 5 1945

