

New Location   
 Drill Deeper   
 Abandonment

✓ JUN 17 1946 2.06 2.11

Company	CARNEGIE NATURAL GAS Co.
Address	PITTSBURGH, PA.
Farm	MARGARET ABEREGG
Tract	Acres 115 Lease No. 9399-73
Well (Farm) No.	4 Serial No. 1220
Elevation (Spirit Level)	1400
Quadrangle	LITTLETON N.E.
County	WETZEL District CLAY <b>11E</b>
Engineer	A. L. HEADLEY
Engineer's Registration No.	
File No.	Drawing No.
Date	11-5-37 Scale 1"=500'

STATE OF WEST VIRGINIA  
 DEPARTMENT OF MINES  
 OIL AND GAS DIVISION  
 CHARLESTON

WELL LOCATION MAP  
 FILE NO. WET-531-A

+ Denotes location of well on United States Topographic Maps, scale 1 to 62,500, latitude and longitude lines being represented by border lines as shown.  
 - Denotes one inch spaces on border line of original tracing.



1002

STATE OF WEST VIRGINIA  
DEPARTMENT OF MINES  
OIL AND GAS DIVISION

**WELL RECORD**  
WELL TO BE ABANDONED

Permit No. 531-A Oil or Gas Well OIL  
(KIND)

Company CARNEGIE NATURAL GAS COMPANY  
Address 1015 FRICK BLDG., PITTSBURGH, PA.  
Farm MARGARET ABEREGG Acres 115  
Location (waters) \_\_\_\_\_  
Well No. 4-1220 Elev. 1400  
District CLAY County WETZEL  
The surface of tract is owned in fee by DAVID ABEREGG  
Address LITTLETON, W.VA.  
Mineral rights are owned by SEE BELOW  
Address \_\_\_\_\_  
Drilling commenced 10-18-23 11-30-24 10-8-26  
Drilling completed 11-20-23 12-2-24 12-3-26  
Date Shot 12-4-26 From 3293 To 3300  
With 20 Qts.  
Open Flow /10ths Water in \_\_\_\_\_ Inch  
/10ths Merc. in \_\_\_\_\_ Inch  
Volume \_\_\_\_\_ Cu. Ft.  
Rock Pressure \_\_\_\_\_ lbs. \_\_\_\_\_ hrs.  
Oil \_\_\_\_\_ bbls., 1st 24 hrs.  
Fresh water \_\_\_\_\_ feet \_\_\_\_\_ feet  
Salt water \_\_\_\_\_ feet \_\_\_\_\_ feet


Casing and Tubing	Used in Drilling	Left in Well	Packers
Size			
16			Kind of Packer
18			
10	270	270	Size of
8 1/4	1635	1635	
6 3/8	2397	2397	Depth set
5 3/16			
3			Perf. top
2	3311		Perf. bottom
Liners Used			Perf. top
			Perf. bottom

CASING CEMENTED \_\_\_\_\_ SIZE \_\_\_\_\_ No. Ft. \_\_\_\_\_ Date \_\_\_\_\_  
COAL WAS ENCOUNTERED AT 1115 FEET \_\_\_\_\_ INCHES  
1215 FEET \_\_\_\_\_ INCHES \_\_\_\_\_ FEET \_\_\_\_\_ INCHES  
\_\_\_\_\_ FEET \_\_\_\_\_ INCHES \_\_\_\_\_ FEET \_\_\_\_\_ INCHES

Formation	Color	Hard or Soft	Top	Bottom	Oil, Gas or Water	Depth Found	Remarks
Mapletown Coal			1115	1120			
Pittsburgh Coal			1215	1223			
Little Dunkard			1595	1615			
Big Dunkard			1715	1760			
1st Salt Sand			1988		Gas	1995-1998	
TOTAL DEPTH 11-20-23				2006			
1st Salt Sand				2015			
2nd Salt Sand			2070		Gas	2110-2114	
TOTAL DEPTH 12-2-24				2117			
2nd Salt Sand				2155			
Marion Sand			2200	2240			
Little Lime			2378	2382			
Pencil Cave			2382	2388			
Big Lime			2390	2445			
Big Injun Sand			2445	2688	Gas Show	2460-2465	
50-Foot Sand			3035	3065			
50-Foot Sand			3225	3240			
Gordon Sand			3283		Oil in Gordon		
TOTAL DEPTH 12-3-26				3311			

MINERAL RIGHTS OWNED BY:

Harley Evely,  
Myrtle and S.L. Long,  
S.B. and Lulu Aberegg,  
David Aberegg,  
Jessie and John Kilecayne, R.F.D.,  
J. H. Aberegg Heirs, % S. L. Long, Atty-in-Fact, Littleton, W.Va.  
Folsom, W. Va.  
Littleton, W. Va.  
Rt. 2, Box 58, Steubenville, Ohio  
Littleton, W.Va.  
Smithfield, W.Va.

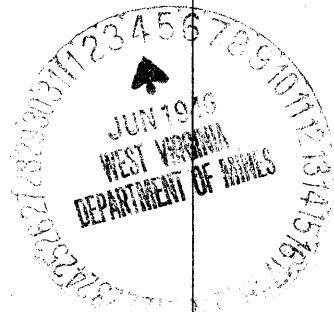

Formation	Color	Hard or Soft	Top	Bottom	Oil, Gas or Water	Depth Found	Remarks

Date JUNE 3, 1946

APPROVED CARNEGIE NATURAL GAS COMPANY, Owner

By B. H. Archer  
(Title) Land Agent.