

surface: L. Everett Morgan, New Martinsville, W.Va
 Pittsburgh Coal: Consolidation Coal Co. Watson Bldg., Fairmont, W.Va.

New Location
 Drill Deeper
 Abandonment

SEP 16 1947

1.59 1161 W
 N 4-5 5.43 E 5

Company	Raad Supply Co.
Address	Salem, W.Va.
Farm	I.D. Morgan
Tract	Acres 441.7 Lease No.
Well (Farm) No.	10 Serial No.
Elevation (Spirit Level)	Floor - 375.89 Ground - 374.89
Quadrangle	Littleton
County	Wetzel District Grant
Engineer	E.C. Tabler
Engineer's Registration No.	
File No.	Drawing No.
Date	Jan 14 th 1947 Scale 1" = 800'

STATE OF WEST VIRGINIA
 DEPARTMENT OF MINES
 OIL AND GAS DIVISION
 CHARLESTON

WELL LOCATION MAP
 FILE NO. WET-601-B

+ Denotes location of well on United States Topographic Maps, scale 1 to 62,500, latitude and longitude lines being represented by border lines as shown.
 - Denotes one inch spaces on border line of original tracing.



STATE OF WEST VIRGINIA
DEPARTMENT OF MINES
OIL AND GAS DIVISION

1055

AP 601-A

WELL RECORD

Permit No. _____ Oil or Gas Well _____
(KIND)


Company Raad Supply Company
Address 184 East Main St., Salem, W. Va.
Farm I. D. Morgan Acres 44.7
Location (waters) _____
Well No. 10 Elev. 875.89
District Grant County Wetzel
The surface of tract is owned in fee by L. E. Morgan
Address New Martinsville, W. Va.
Mineral rights are owned by Consolidation Coal Co.
Address Watson Bldg. Fairmont, W. Va.
Drilling commenced _____
Drilling completed December 26, 1896
Date Shot _____ From _____ To _____
With _____

Casing and Tubing	Used in Drilling	Left in Well	Packers
Size			Kind of Packer
16			
18			
10	394'	None	Size of
8 1/2	1185'	None	
6	1518'	1518'	Depth set
5 3/16	1678'	1678'	
3			Perf. top
2		2054	Perf. bottom
Liners Used			Perf. top
			Perf. bottom

Open Flow _____ /10ths Water in _____ Inch
_____ /10ths Merc. in _____ Inch
Volume _____ Cu. Ft.
Rock Pressure _____ lbs _____ hrs.
Oil _____ bbls., 1st 24 hrs.
Fresh water _____ feet _____ feet
Salt water _____ feet _____ feet

CASING CEMENTED _____ SIZE _____ No. Ft. _____ Date _____
COAL WAS ENCOUNTERED AT 664 FEET 72 INCHES
_____ FEET _____ INCHES _____ FEET _____ INCHES
_____ FEET _____ INCHES _____ FEET _____ INCHES

Formation	Color	Hard or Soft	Top	Bottom	Oil, Gas or Water	Depth Found	Remarks
Conductor			27				
Pittsburgh	Coal		658	664			
Salt Sand			1465	1660			
Pencil Cave			1878	1885			
Big Lime			1908	1958			
Big Injun Sand			1958				
Gas			1958		Gas		
1st. Pay Oil			2038		Oil		
2nd Pay Oil			2044		Oil		
Total Depth				2054			

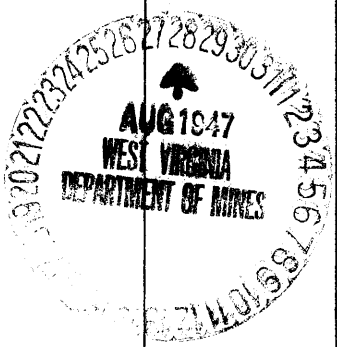

Formation	Color	Hard or Soft	Top	Bottom	Oil, Gas or Water	Depth Found	Remarks

Date Aug. 25, 1947

APPROVED Road Supply Co., Owner

By J. M. Road, Mgr. owner
(Title) Mgr.