


Company Hope Natural Gas Co.
 Address Clarksburg W. Va.
 Farm John C. Poe
 Tract _____ Acres 516 Lease No. 4300
 Well (Farm) No. 142 Serial No. 500-3910
 Elevation (Spirit Level) 1094'-1356
 Quadrangle Littleton
 County Wetzel District Grant
 Engineer Wm Brewer
 Engineer's Registration No. 900
 File No. _____ Drawing No. _____
 Date Mar. 5, 1943 Scale 1" = 40'

STATE OF WEST VIRGINIA
 DEPARTMENT OF MINES
 OIL AND GAS DIVISION
 CHARLESTON

WELL LOCATION MAP
 FILE NO. WET-1115-15

+ Denotes location of well on United States Topographic Maps, scale 1 to 62,500, latitude and longitude lines being represented by border lines as shown.

- Denotes one inch spaces on border line of original tracing.

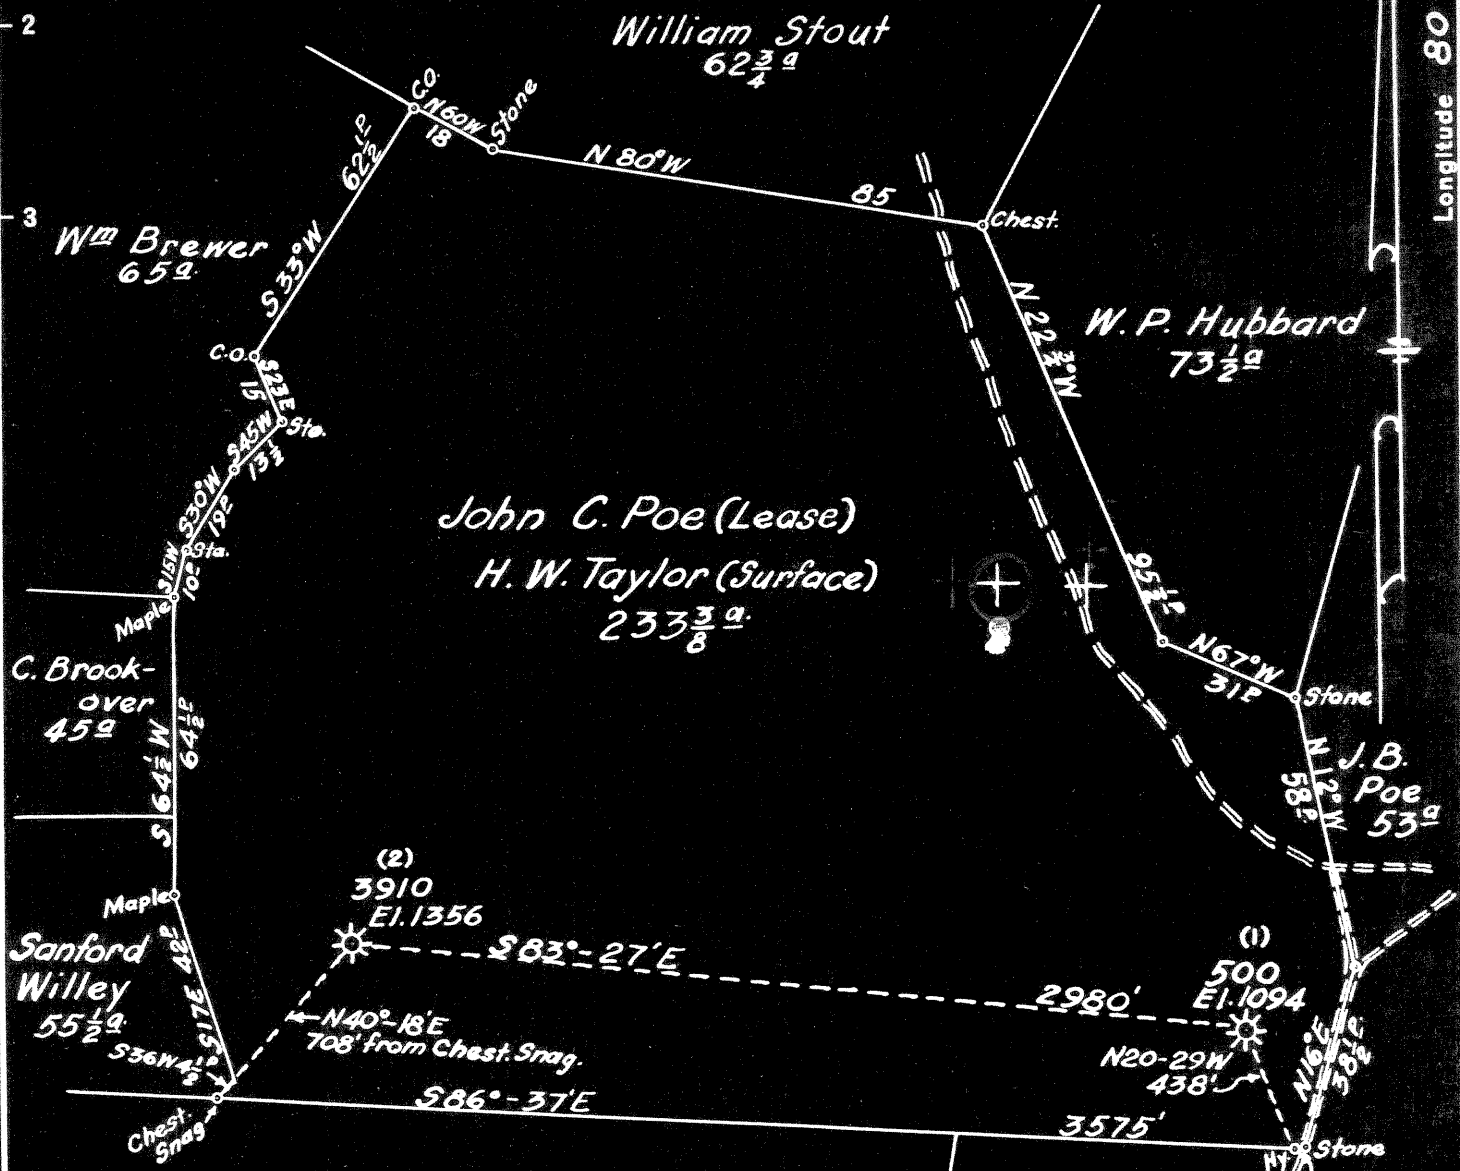

	5.10	S
1(500)	1.96	W
2(3910)	5.08	S
	2.41	W

well # 3910
531 A

Map Sheet 32-Squares N11E5, F.B. 737 P4-5

New Location
 Drill Deeper
 Abandonment (500)

Company Hope Natural Gas Co.
 Address Clarksburg W. Va.
 Farm John C. Poe
 Tract _____ Acres 516 Lease No. 4300
 Well (Farm) No. 142 Serial No. 500-3910
 Elevation (Spirit Level) 1094-1356
 Quadrangle Littleton
 County Wetzel District Grant
 Engineer Wm Brewer
 Engineer's Registration No. 900
 File No. _____ Drawing No. _____
 Date Mar. 5, 1943 Scale 1" = 40'

STATE OF WEST VIRGINIA
 DEPARTMENT OF MINES
 OIL AND GAS DIVISION
 CHARLESTON

WELL LOCATION MAP

FILE NO. WET-111E5-FB-737-P4-5

+ Denotes location of well on United States Topographic Maps, scale 1 to 62,500, latitude and longitude lines being represented by border lines as shown.

- Denotes one inch spaces on border line of original tracing.



STATE OF WEST VIRGINIA
DEPARTMENT OF MINES
OIL AND GAS DIVISION

1084

WELL RECORD

Oil or Gas Well (KIND)

Permit No. 691-A

Company Hope Natural Gas Company.

Address 445 West Main St. Clarksburg, W. Va.

Farm John C. Poe Acres 516

Location (waters) _____

Well No. 3910 Elev. 1356

District Grant County Wetzel

The surface of tract is owned in fee by _____
Address _____

Mineral rights are owned by _____
Address _____

Drilling commenced October 13, 1915

Drilling completed April 27, 1916

Date Shot _____ From _____ To _____

With _____

Open Flow _____ /10ths Water in _____ Inch
_____ /10ths Merc. in _____ Inch

Volume _____ Cu. Ft.

Rock Pressure _____ lbs. _____ hrs.

Oil _____ bbls., 1st 24 hrs.

Fresh water _____ feet _____ feet

Salt water 2020 feet _____ feet

Casing and Tubing	Used in Drilling	Left in Well	Packers
Size			Kind of Packer
16			
13			
10	588	588	Size of
8 1/2	1638	1638	
6 5/8	2307	2307	Depth set
5 3/16	3208	1113	
3			Perf. top
2			Perf. bottom
Liners Used			Perf. top
			Perf. bottom

NOT


CASING CEMENTED _____ SIZE _____ No. Ft. _____ Date _____

COAL WAS ENCOUNTERED AT 1118 FEET 24 INCHES

_____ FEET _____ INCHES _____ FEET _____ INCHES

_____ FEET _____ INCHES _____ FEET _____ INCHES

Formation	Color	Hard or Soft	Top	Bottom	Oil, Gas or Water	Depth Found	Remarks
Pittsburgh Coal			1118	1120			
Little Dunkard			1530	1575			
Big Dunkard			1595	1655			
First Salt			1892	1940			
Second Salt			2003	2248	water	2020	
Maxon			2252	2275			
Little Lime			2278	2296			
Pencil cave			2296	2303			
Big Lime			2303	2374			
Big Injun			2374	2562	show gas	2452	
Berea			2760	2765			
Fifty foot			3055	3095			
Thirty foot			3115	3132			
Gordon Stray			3140	3183			
Gordon			3208	3226	gas	3208	
Fourth			3251	3258			
Total depth				3294			

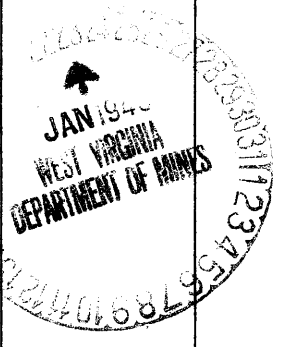

Formation	Color	Hard or Soft	Top	Bottom	Oil, Gas or Water	Depth Found	Remarks

Date **January 21, 1948**, 19__

APPROVED **Hope Natural Gas Company.**, Owner

By _____

(Title) *[Signature]*

