Longitude

Latitude

12,48s

Topo Location

7.5' Loc.\_\_\_\_\_\_ 15' Loc.\_\_\_\_\_ (calc.)

Company Little Greek Oil Co


Farm HH Little \* 2

7.5' Quad Littleton

District Center

WELL LOCATION PLAT

County 103 Permit 30663

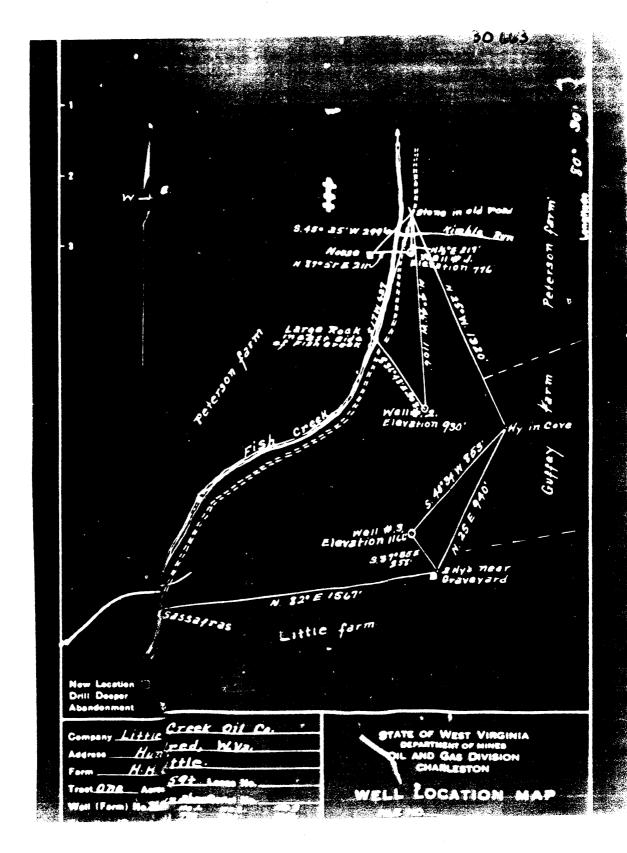



## DEPARTMENT OF MINES

OIL AND GAS DIVISION



Permit No. 663-A

## **WELL RECORD**

ermit No.	0 /			Oil or Gas Well (KIND)				
ompany Little Creek Cil Co., L. M. Snider Opr. ddress Hundred, West Virginia				Casing and Tubing	Used in Drilling	Left in Well	Packers	
		A		Size				
•		E E		16		-	Kind of	Packer
istrict Class	Center	_CountyCounty	1	13			-	
he surface of tra		fee by		10	<u>501</u>	1528	Size of_	
(ineral rights are		Address		8¼ 6%	2008	2008	Depth s	et
	-	Address		5 3/16	627	Pulled	ļ <del> </del>	. Tajin sa pere
rilling commenced September 11, 1924							1	p
rilling completed October 50, 1924 ate Shot No Record From To							Perf. bottom Perf. top	
ith							1	ttom
	•	in <b>No Record</b>				1	<u>!</u>	
		in		CASING CEMI	ENTED	_SIZE	.No. Ft	
		lbs.						
No Reco	rd		bbls., 1st 24 hrs.	COAL WAS E				
		feet		824 FEET				
It water	<b>0</b> *	feet	feet	FEE	<u> </u>			
Formation	Color	Hard or Soft	Тор	Bottom	Oil, Gas or Water	Depth Found		Remark
ig Dunkurd irst Salt S second Salt ittle Line wasil Cave ig Line ig Line orden Sand	Sand Sand		1328 1670 1785 1960 1970 1 960 2042 2882	1360 1764 1840 1970 1980 2038 2303	Gas Gas Gas & Gil	1755 1745 2071 2150 2895-290	Star .	
otal Depth				2900				
				e de la companya de	C			
			,					
		33456			•			
	ै हर्	MAY 1948						
	50.77.2824	WEST VARSON						
	262	OPARIENI OF						
	4	40			,			
	]	(6/85021223)						
			1.0			1.0	1	