

New Location
 Drill Deeper
 Abandonment

✓ 3.60
 197
 MAY 10 1948

Company BRITTON & BERGE
 Address VIENNA, W.V.A.
 Farm HELLEN M. JAMISON
 Tract _____ Acres 201 Lease No. _____
 Well (Farm) No. 14 Serial No. _____
 Elevation (Spirit Level) 1176'
 Quadrangle CENTERPOINT, N.W.
 County WETZEL District GRANT
 Engineer R.L. SWEENEY
 Engineer's Registration No. _____
 File No. _____ Drawing No. _____
 Date 4-24-48 Scale 1"=40 FEET

STATE OF WEST VIRGINIA
 DEPARTMENT OF MINES
 OIL AND GAS DIVISION
 CHARLESTON

WELL LOCATION MAP
 FILE NO. WEL-664-A

+ Denotes location of well on United States Topographic Maps, scale 1 to 62,500, latitude and longitude lines being represented by border lines as shown.
 - Denotes one inch spaces on border line of original tracing.



STATE OF WEST VIRGINIA
DEPARTMENT OF MINES
OIL AND GAS DIVISION

1123

664-A

WELL RECORD

Permit No. _____ Oil or Gas Well 011
(KIND)


Company Britten and Borge
Address Vienna, W.Va.
Farm Hellen M. Jamison Acres 201
Location (waters) Bob Cambell Run
Well No. 14 Elev. 1176
District Grant County Netzel
The surface of tract is owned in fee by Hellen M. Jamison
Address _____
Mineral rights are owned by Hellen M. Jamison
Address _____
Drilling commenced _____
Drilling completed December 27, 1900
Date Shot 4-23-30 From 3101 To 3109
With 70 qt
Open Flow _____ /10ths Water in _____ Inch
_____ /10ths Merc. in _____ Inch
Volume _____ Cu. Ft.
Rock Pressure _____ lbs. _____ hrs.
Oil _____ bbls., 1st 24 hrs.
Fresh water _____ feet _____ feet
Salt water _____ feet _____ feet

Casing and Tubing	Used in Drilling	Left in Well	Packers
Size			Kind of Packer
16			
13			
10	500		Size of
8 1/4	1460		
6 5/8	2293	2293	Depth set
5 3/16	2565	2565	
3			Perf. top
2			Perf. bottom
Liners Used			Perf. top
			Perf. bottom

CASING CEMENTED _____ SIZE _____ No. Ft. _____ Date _____
COAL WAS ENCOUNTERED AT 1000 FEET _____ INCHES
_____ FEET _____ INCHES FEET _____ INCHES
_____ FEET _____ INCHES FEET _____ INCHES

Formation	Color	Hard or Soft	Top	Bottom	Oil, Gas or Water	Depth Found	Remarks
Pgh. Coal			1000				
Big Injun			2320	2483			
Stray			3073				
Gordon			3088	3110			
Oil					Oil	3098	
Total Depth				3113			

This is the record as kept by the South Penn Oil Company

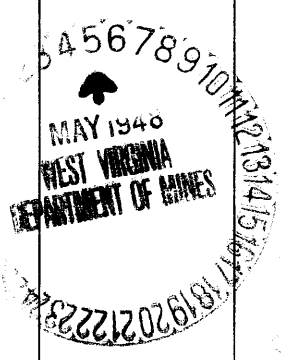

SEP 23 1948