

New Location
 Drill Deeper
 Abandonment

SEP - 7 1948

Map Sh. 39 N8W3 FB. 897 P-27.

Company	Hope Natural Gas Co.
Address	Clarksburg, W. Va
Farm	Charley L. Newman
Tract	Acres 75 Lease No. 23764
Well (Farm) No.	Serial No. 2286
Elevation (Spirit Level)	841'
Quadrangle	Littleton
County	Wetzel District Grant
Engineer	W. M. Bowers
Engineer's Registration No.	900
File No.	Drawing No.
Date	7-8-48 Scale 1" = 400'

STATE OF WEST VIRGINIA
 DEPARTMENT OF MINES
 OIL AND GAS DIVISION
 CHARLESTON

WELL LOCATION MAP
 FILE NO. WET-685-A

+ Denotes location of well on United States Topographic Maps, scale 1 to 62,500, latitude and longitude lines being represented by border lines as shown.
 - Denotes one inch spaces on border line of original tracing.



STATE OF WEST VIRGINIA
DEPARTMENT OF MINES
OIL AND GAS DIVISION

1789

085-A

WELL RECORD

Permit No. _____ **XX** ~~Oil~~ or Gas Well _____ (KIND)


Company Hope Natural Gas Company.
Address 445 West Main St. Clarksburg, W. Va.
Farm Charles L. Newman Acres 75
Location (waters) _____
Well No. 2286 Elev. 841
District Grant County Wetzel
The surface of tract is owned in fee by _____
Address _____
Mineral rights are owned by _____
Address _____
Drilling commenced Sept. 25, 1911
Drilling completed Nov. 22, 1911
Date Shot _____ From _____ To _____
With _____
Open Flow _____ /10ths Water in _____ Inch
_____ /10ths Merc. in _____ Inch
Volume _____ Cu. Ft.
Rock Pressure _____ lbs. _____ hrs.
Oil _____ bbls., 1st 24 hrs.
Fresh water _____ feet _____ feet
Salt water 1490 feet _____ feet

Casing and Tubing	Used in Drilling	Left in Well	Packers
Size			Kind of Packer
16			
13			
10	501	Pulled	Size of
8 1/2	1042	Pulled	
6 1/2	1798	1798	Depth set
5 3/16	2599	2599	
3			Perf. top
2			Perf. bottom
Liners Used			Perf. top
			Perf. bottom

CASING CEMENTED **NOT** SIZE _____ No. Ft. _____ Date _____

COAL WAS ENCOUNTERED AT 60 FEET 48 INCHES
180 FEET 36 INCHES 270 FEET 36 INCHES
535 FEET 36 INCHES _____ FEET _____ INCHES

Formation	Color	Hard or Soft	Top	Bottom	Oil, Gas or Water	Depth Found	Remarks
Coal			60	64			
Coal			180	183			
Coal			270	273			
Pitts. Coal			535	538			
Big Dunkard			1020	1040			
First Salt			1300	1349			
Second Salt			1362	1560	water	1490	
Little Lime			1737	1746			
Pencil cave			1746	1749			
Big Lime			1749	1800	show gas	1797	
Big Injun			1800	2011			
Squaw			2015	2028			
Berea			2175	2200			
Gantz			2213	2245			
Fifty foot			2386	2394			
Gordon Stray			2597	2617	gas	2599 2604	
Gordon			2628	2652	gas	2633	
Total depth				2703			

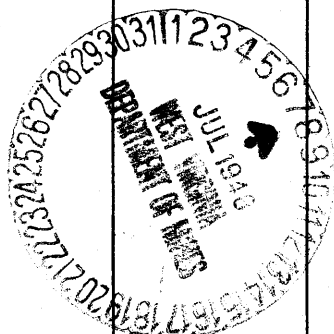

Formation	Color	Hard or Soft	Top	Bottom	Oil, Gas or Water	Depth Found	Remarks

Date July 2, 1948, 19

APPROVED Hope Natural Gas Company., Owner

By _____

(Title) *JAA*