

Surface: Frank Ensminger, RFD #1, Smithfield, Wetzel Co., W.Va.  
 Coal: Harry Shaw, 425 Morgantown Ave., Fairmont, W.Va.

New Location   
 Drill Deeper   
 Abandonment

On Map # 2853

SEP - 7 1948

0.78 0.84 W  
 4.08 4.06 Q  
 NA-5 E6

Company The Interstate Pipe & Supply Co.  
 Address Marietta Ohio  
 Farm I. D. Morgan  
 Tract \_\_\_\_\_ Acres 66 Lease No. \_\_\_\_\_  
 Well (Farm) No. 42 Serial No. \_\_\_\_\_  
 Elevation (Spirit Level) Floor - 1105.28  
Ground - 1102.78  
 Quadrangle LITTLETON  
 County Wetzel District Grant  
 Engineer E. C. Tabler  
 Engineer's Registration No. \_\_\_\_\_  
 File No. \_\_\_\_\_ Drawing No. \_\_\_\_\_  
 Date April 15<sup>th</sup> 1948 Scale 1" = 800 Feet

STATE OF WEST VIRGINIA  
 DEPARTMENT OF MINES  
 OIL AND GAS DIVISION  
 CHARLESTON

WELL LOCATION MAP  
 FILE NO. WET-1286-A

+ Denotes location of well on United States Topographic Maps, scale 1 to 62,500, latitude and longitude lines being represented by border lines as shown.  
 - Denotes one inch spaces on border line of original tracing.



STATE OF WEST VIRGINIA  
DEPARTMENT OF MINES  
OIL AND GAS DIVISION

1128

WELL RECORD

Permit No. 656 A Oil or Gas Well Oil (KIND)

Company The Interstate Pipe & Supply Company  
 Address Box 611, Marietta, Ohio  
 Farm I. D. Morgan Acres 66  
 Location (waters) Prices Fork  
 Well No. 42 Elev. 105.28  
 District Grant County Wetzel  
 The surface of tract is owned in fee by Frank Snaringer  
A. F. D. 1 Address Smithfield, W. Va.  
 Mineral rights are owned by Harry Shaw  
425 Morgantown, Ave. Address Fairmont, W. Va.  
 Drilling commenced Nov. 20, 1914  
 Drilling completed Jan. 4, 1915  
 Date Shot 1915-16-17 From 3020 To 3022  
 With 30 - 50 - 60  
 Open Flow /10ths Water in \_\_\_\_\_ Inch  
 /10ths Merc. in \_\_\_\_\_ Inch  
 Volume \_\_\_\_\_ Cu. Ft.  
 Rock Pressure \_\_\_\_\_ lbs. \_\_\_\_\_ hrs.  
 Oil \_\_\_\_\_ bbls., 1st 24 hrs.  
 Fresh water \_\_\_\_\_ feet \_\_\_\_\_ feet  
 Salt water \_\_\_\_\_ feet \_\_\_\_\_ feet


Casing and Tubing	Used in Drilling	Left in Well	Packers
Size			
16			Kind of Packer
13			
10	620	None	Size of
8 1/4	1445	None	
6 5/8	2141	2141	Depth set
5 3/16	2585	2585	
3			Perf. top
2			Perf. bottom
Liners Used			Perf. top
			Perf. bottom

CASING CEMENTED \_\_\_\_\_ SIZE \_\_\_\_\_ No. Ft. \_\_\_\_\_ Date \_\_\_\_\_  
 COAL WAS ENCOUNTERED AT 905 FEET 84 INCHES  
 \_\_\_\_\_ FEET \_\_\_\_\_ INCHES FEET \_\_\_\_\_ INCHES  
 \_\_\_\_\_ FEET \_\_\_\_\_ INCHES FEET \_\_\_\_\_ INCHES

Formation	Color	Hard or Soft	Top	Bottom	Oil, Gas or Water	Depth Found	Remarks
Conductor				16			
Pitts. Coal			905	912			
Gas Sand			1575	1685			
Little Dunkard			1252	1270			
Big Dunkard			1400	1425			
1st. Salt Sand			1710	1760			
2nd. Salt Sand			1800	1900			
Water			1756	1818			
Water			1890				
Big Lime			2141	2204			
Little Lime			2124	2136			
Pencil Cave			2136	2141			
Big Injun			2204	2320			
Oil & Water			2286	2291			
2nd. Pay Oil			2293	2299			
Boulder			2415	2950			
Thirty Foot			2833	2847			
Stray Sand			2973	3016			
Show of Oil			2977				
Gordon Sand			3020				
Gas			3022				
1st. Pay Oil			3024	3030			
Total				3033			

DRILLED DEEPER

Commenced - 2/4/15, Completed, 3/9/15, Original Depth. 2301, Final Depth 3033  
 Initial Prods 5 bbls.  
 Remarks : Drilled to B. I. Sand and tested for 30 days and drilled to Gordon.

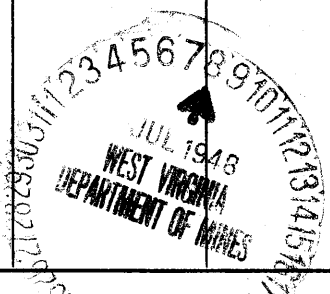

Formation	Color	Hard or Soft	Top	Bottom	Oil, Gas or Water	Depth Found	Remarks

Date July 6, 1948

APPROVED THE INTERSTATE PIPE & SUPPLY COMPANY, Owner

By Adolph Beseuf  
(Title) P.A.