

Company Randall-Zogg Supply Co.  
 Address Owensboro Ky.  
 Farm L.S. Hoyt  
 Tract \_\_\_\_\_ Acres 1100 Lease No. \_\_\_\_\_  
 Well (Farm) No. 58 Serial No. \_\_\_\_\_  
 Elevation (Spirit Level) Floor - 1291.09  
 Ground - 1289.00  
 Quadrangle LITTLETON  
 County Wetzel District Grant  
 Engineer E.C. Tabler  
 Engineer's Registration No. \_\_\_\_\_  
 File No. \_\_\_\_\_ Drawing No. \_\_\_\_\_  
 Date May 8<sup>th</sup> 1948 Scale 1" = 800 Feet.

STATE OF WEST VIRGINIA  
 DEPARTMENT OF MINES  
 OIL AND GAS DIVISION  
 CHARLESTON

WELL LOCATION MAP  
 FILE NO. WET-689-A

+ Denotes location of well on United States Topographic Maps, scale 1 to 52,500, latitude and longitude lines being represented by border lines as shown.

- Denotes one inch spaces on border line of original tracing.



STATE OF WEST VIRGINIA  
DEPARTMENT OF MINES  
OIL AND GAS DIVISION

1124

689-A

WELL RECORD

Permit No. \_\_\_\_\_ Oil or Gas Well **OIL** (KIND)

Company **RANDALL-ZOGG SUPPLY COMPANY**  
Address **BOX 526, CHELSTON, 22 W. VA.**  
Farm **L. S. Hoyt** Acres **1100**  
Location (waters) \_\_\_\_\_  
Well No. **Fifty Eight (58)** Elev. **1891.00**  
District \_\_\_\_\_ County **Wayne**  
The surface of tract is owned in fee by **Alex C. Hoyt, et al**  
Address **New Castle, Pa.**  
Mineral rights are owned by **Alex C. Hoyt, et al**  
Address **New Castle, Pa.**

Drilling commenced \_\_\_\_\_  
Drilling completed **June 30, 1902**  
Date Shot **SEE BELOW** From \_\_\_\_\_ To \_\_\_\_\_  
With \_\_\_\_\_

Open Flow /10ths Water in \_\_\_\_\_ Inch  
/10ths Merc. in \_\_\_\_\_ Inch  
Volume \_\_\_\_\_ Cu. Ft.  
Rock Pressure \_\_\_\_\_ lbs. \_\_\_\_\_ hrs.  
Oil **No Record** bbls., 1st 24 hrs.  
Fresh water \_\_\_\_\_ feet \_\_\_\_\_ feet  
Salt water \_\_\_\_\_ feet \_\_\_\_\_ feet

Casing and Tubing	Used in Drilling	Left in Well	Packers
Size			Kind of Packer
16			
13			
10	<b>600'</b>		Size of
8 3/4	<b>1690'</b>		
6 3/4	<b>2400'</b>	<b>2400'</b>	Depth set
5 3/16	<b>2582'</b>	<b>2582'</b>	
3			Perf. top
2	<b>3229'</b>	<b>3229'</b>	Perf. bottom
Liners Used			Perf. top
			Perf. bottom

CASING CEMENTED \_\_\_\_\_ SIZE \_\_\_\_\_ No. Ft. \_\_\_\_\_ Date \_\_\_\_\_


COAL WAS ENCOUNTERED AT **1190** FEET \_\_\_\_\_ INCHES  
\_\_\_\_\_ FEET \_\_\_\_\_ INCHES \_\_\_\_\_ FEET \_\_\_\_\_ INCHES  
\_\_\_\_\_ FEET \_\_\_\_\_ INCHES \_\_\_\_\_ FEET \_\_\_\_\_ INCHES

Formation	Color	Hard or Soft	Top	Bottom	Oil, Gas or Water	Depth Found	Remarks
Pittsburgh Coal			<b>1190'</b>				
Big Injun Sand			<b>2590'</b>	<b>2600'</b>			
Stray Sand			<b>3168'</b>	<b>3193'</b>			
Hole Reduced			<b>3198'</b>				
Garden Sand			<b>3199'</b>	<b>3224'</b>	<b>OIL</b>	<b>3205'</b>	
Total Depth				<b>3229'</b>			

SHOT RECORD

July 4th, 1902 Shot with 50 Qts.  
October 28th, 1902 " " 60 "  
May 1903 " " 80 "  
July 1903 " " 120 "  
January 11th, 1911 " " 100 "

NOTE - January 11th, 1911: Well bridged 250' from bottom, there is iron in this well 80' from bottom, also in bottom of hole. July 15, 1917 Well cleaned and lined, 101' of 5-3/16" casing run on 5" X 6" Callahan cave packer, Top 3065'. February 9th, 1923: Run 2486' of 5-3/16" casing on Hook Wall packer.

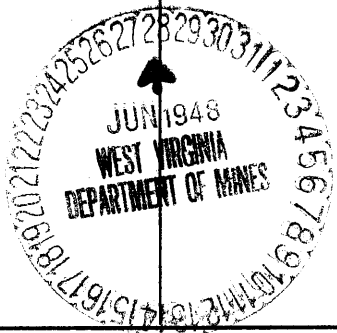

Formation	Color	Hard or Soft	Top	Bottom	Oil, Gas or Water	Depth Found	Remarks

Date JUNE 28th, 1948

APPROVED RANDALL-ZOGG SUPPLY COMPANY, Owner

By *[Signature]*  
(Title) Agent