

Surface: On which both 9 2 15 Smith-Edgell are located: H.L. Smith Hrs.  
 Address: Miss Mary Laurie Smith, # 1111 E. Main St. Richmond, Va.

Coal: state of West Virginia

#15	4.71	S
	3.90	W
#9	5.02	S
	3.95	W

New Location   
 Drill Deeper   
 Abandonment  On 400' map # 2851

N 5 E 3

Company The Interstate Pipe & Supply Co.  
 Address Marietta Ohio  
 Farm Smith - Edgell  
 Tract \_\_\_\_\_ Acres 352 Lease No. \_\_\_\_\_  
 Well (Farm) No. 192 <sup>15</sup> Serial No. 1013.25  
 Elevation (Spirit Level) 964.62  
 Quadrangle LITTLETON  
 County Wetzel District Grant  
 Engineer E.C. Tabler  
 Engineer's Registration No. \_\_\_\_\_  
 File No. \_\_\_\_\_ Drawing No. \_\_\_\_\_  
 Date Sept 14<sup>th</sup> 1948 Scale 1" = 800 Feet

STATE OF WEST VIRGINIA  
 DEPARTMENT OF MINES  
 OIL AND GAS DIVISION  
 CHARLESTON

WELL LOCATION MAP  
 FILE NO. WCE-728-A-#15  
WCE-729-A-#9

+ Denotes location of well on United States Topographic Maps, scale 1 to 62,500, latitude and longitude lines being represented by border lines as shown.  
 - Denotes one inch spaces on border line of original tracing.



STATE OF WEST VIRGINIA  
DEPARTMENT OF MINES  
OIL AND GAS DIVISION

1178

WELL RECORD

Permit No. Ab 728-A

Oil or Gas Well Oil  
(KIND)


Company The Interstate Pipe & Supply Company  
Address P. O. Box 611, Marietta, Ohio  
Farm Smith-Edgell Acres 352  
Location (waters) Fallen Timber Run  
Well No. 15 Elev. 964.62  
District Grant County Wetzel  
The surface of tract is owned in fee by H. L. Smith Heirs  
Mary Laurie Smith Address 1111 E. Main Street  
Richmond, Virginia  
Mineral rights are owned by State of West Virginia  
Address Charleston, W. Va.  
Drilling commenced Feb. 15, 1915  
Drilling completed April 9, 1915  
Date Shot 1915 From 2881 To 2891  
With \_\_\_\_\_

Casing and Tubing	Used in Drilling	Left in Well	Packers
Size			
16			Kind of Packer
13			
10	415	none	Size of
8 1/2	1201	none	
6 5/8	2019	2019	Depth set
5 3/16	2600	2600	
3			Perf. top
2			Perf. bottom
Liners Used			Perf. top
4 x 4-1/2	316	316	Perf. bottom

Open Flow \_\_\_\_\_ /10ths Water in \_\_\_\_\_ Inch  
\_\_\_\_\_ /10ths Merc. in \_\_\_\_\_ Inch  
Volume \_\_\_\_\_ Cu. Ft.  
Rock Pressure \_\_\_\_\_ lbs. \_\_\_\_\_ hrs.  
Oil \_\_\_\_\_ bbls., 1st 24 hrs.  
Fresh water \_\_\_\_\_ feet \_\_\_\_\_ feet  
Salt water \_\_\_\_\_ feet \_\_\_\_\_ feet

CASING CEMENTED \_\_\_\_\_ SIZE \_\_\_\_\_ No. Ft. \_\_\_\_\_ Date \_\_\_\_\_  
COAL WAS ENCOUNTERED AT 746 FEET 96 INCHES  
\_\_\_\_\_ FEET \_\_\_\_\_ INCHES \_\_\_\_\_ FEET \_\_\_\_\_ INCHES  
\_\_\_\_\_ FEET \_\_\_\_\_ INCHES \_\_\_\_\_ FEET \_\_\_\_\_ INCHES

Formation	Color	Hard or Soft	Top	Bottom	Oil, Gas or Water	Depth Found	Remarks
Conductor				14			
Bluff Sand			475	516			
Pittsburgh Coal			746	754			
Big Dunkard			1209	1235			
Gas Sand			1384	1446			
First Salt Sand			1553	1627			
Second Salt Sand			1701	1801			
Maxon			1839	1861			
Lime			1961	1982			
Soft Slate			1982	2002			
Little Lime			2002	2012			
Pencil Cave			2012	2014			
Big Lime			2014	2075			
Big Injun			2075	2253			
Fifty Foot			2598	2606			
Gordon Stray			2788	2822			
Gordon			2878	2895			
Oil			2882	2888			
Total Depth				2895			

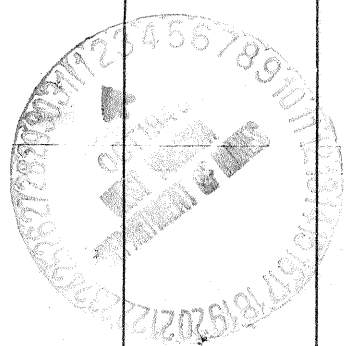

Steel shoe on bottom of 6-5/8" casing. Steel shoe on bottom of 5-3/16" casing  
March 1932: Cleaned out and filled shot hole with 79 bu. of gravel and then inserted 4 x 4-1/2" liner. Slotted joint.  
1936: Rig lowered and 4' 1" taken off top of casing. All measurements accordingly

Formation	Color	Hard or Soft	Top	Bottom	Oil, Gas or Water	Depth Found	Remarks

Date September 29, 19 48

APPROVED THE INTERSTATE PIPE & SUPPLY COMPANY Owner

By H. H. Bensen  
(Title) P.A.