

1.81 S  
1.19 W

- New Location
- Drill Deeper
- Abandonment

Map Sh 39 N 7W 4 FB 920 P. 31-32

Company Hope Natural Gas Co.  
 Address Clarksburg, W. Va.  
 Farm Andrew Haught  
 Tract \_\_\_\_\_ Acres 100 Lease No. 486  
 Well (Farm) No. \_\_\_\_\_ Serial No. 24  
 Elevation (Spirit Level) 1116'  
 Quadrangle Littleton  
 County Wetzel District Greene  
 Engineer Wm Bowers  
 Engineer's Registration No. 900  
 File No. \_\_\_\_\_ Drawing No. \_\_\_\_\_  
 Date 1-21-49 Scale 1" = 40 P

STATE OF WEST VIRGINIA  
 DEPARTMENT OF MINES  
 OIL AND GAS DIVISION  
 CHARLESTON

**WELL LOCATION MAP**  
 FILE NO. Wet-780-A

+ Denotes location of well on United States Topographic Maps, scale 1 to 62,500, latitude and longitude lines being represented by border lines as shown.

- Denotes one inch spaces on border line of original tracing.



STATE OF WEST VIRGINIA  
DEPARTMENT OF MINES  
OIL AND GAS DIVISION

1276

780-A

WELL RECORD

Permit No. \_\_\_\_\_

Oil or Gas Well \_\_\_\_\_  
(KIND)


Company Hops Natural Gas Company.  
Address 445 West Main St. Clarksburg, W.Va.  
Farm A.J. Haught Acres 100  
Location (waters) \_\_\_\_\_  
Well No. 24 Elev. 1116  
District Green County Wetzel  
The surface of tract is owned in fee by \_\_\_\_\_  
Address \_\_\_\_\_  
Mineral rights are owned by \_\_\_\_\_  
Address \_\_\_\_\_

Casing and Tubing	Used in Drilling	Left in Well	Packers
Size			Kind of Packer
16			
13			
10	1314	1314	Size of
8 1/4	1670	Pulled	
6 5/8	2015	Pulled	Depth set
5 3/16	2410	2410	
3			Perf. top
2			Perf. bottom
Liners Used			Perf. top
			Perf. bottom

Drilling commenced \_\_\_\_\_  
Drilling completed November 11, 1900  
Date Shot \_\_\_\_\_ From \_\_\_\_\_ To \_\_\_\_\_  
With \_\_\_\_\_  
Open Flow \_\_\_\_\_ /10ths Water in \_\_\_\_\_ Inch  
\_\_\_\_\_ /10ths Merc. in \_\_\_\_\_ Inch  
Volume \_\_\_\_\_ Cu. Ft.  
Rock Pressure \_\_\_\_\_ lbs. \_\_\_\_\_ hrs.  
Oil \_\_\_\_\_ bbls., 1st 24 hrs.  
Fresh water none recorded feet \_\_\_\_\_ feet  
Salt water none recorded feet \_\_\_\_\_ feet

CASING CEMENTED \_\_\_\_\_ SIZE \_\_\_\_\_ No. Ft. \_\_\_\_\_ Date \_\_\_\_\_  
COAL WAS ENCOUNTERED AT 840 FEET 96"? INCHES  
\_\_\_\_\_ FEET \_\_\_\_\_ INCHES \_\_\_\_\_ FEET \_\_\_\_\_ INCHES  
\_\_\_\_\_ FEET \_\_\_\_\_ INCHES \_\_\_\_\_ FEET \_\_\_\_\_ INCHES

Formation	Color	Hard or Soft	Top	Bottom	Oil, Gas or Water	Depth Found	Remarks
Pittsburgh Coal			840	848?			
Big Injun			2170	2360			
Gordon Stray			2896	2922	gas	2898	
Gordon			2932	2940			
Fifth			3115	3120			
Total depth				3310			
Was filled back to				2907			

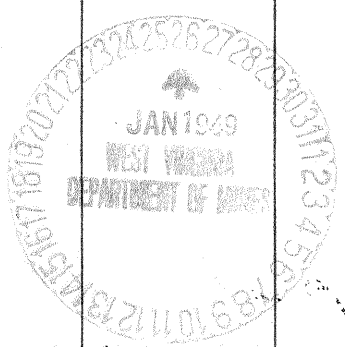

Formation	Color	Hard or Soft	Top	Bottom	Oil, Gas or Water	Depth Found	Remarks

Date January 17, 1949, 19

APPROVED Hope Natural Gas Company, Owner

By \_\_\_\_\_

(Title)

*RR*