

1.52 S
0.42 W

New Location..
 Drill Deeper.....
 Abandonment.....

Map Sh 39 N9W3 FB 932 P 36

Company Hope Natural Gas Co.
 Address Clarksburg, W. Va.
 Farm T.M. Stone
 Tract _____ Acres 250 Lease No. 398
 Well (Farm) No. _____ Serial No. 26
 Elevation (Spirit Level) 725'
 Quadrangle Littleton
 County Wetzel District Grant
 Engineer Wm Bower
 Engineer's Registration No. 900
 File No. _____ Drawing No. _____
 Date 6-7-49 Scale 1" = 1320'

STATE OF WEST VIRGINIA
 DEPARTMENT OF MINES
 OIL AND GAS DIVISION
 CHARLESTON

WELL LOCATION MAP
 FILE NO. Wct-829-A

+ Denotes location of well on United States Topographic Maps, scale 1 to 62,500, latitude and longitude lines being represented by border lines as shown.

- Denotes one inch spaces on border line of original tracing.



STATE OF WEST VIRGINIA
DEPARTMENT OF MINES
OIL AND GAS DIVISION

1295

WELL RECORD

Permit No. 829-A

Oil or Gas Well _____
(KIND)


Company Hope Natural Gas Company.
Address 445 West Main St. Clarksburg, W. Va.
Farm T.M. Stone Acres 250
Location (waters) _____
Well No. 26 Elev. 725
District Grant County Wetzel
The surface of tract is owned in fee by _____
Address _____
Mineral rights are owned by _____
Address _____
Drilling commenced June 14, 1901
Drilling completed July 30, 1901
Date Shot _____ From _____ To _____
With _____
Open Flow _____ /10ths Water in _____ Inch
_____ /10ths Merc. in _____ Inch
Volume _____ Cu. Ft.
Rock Pressure _____ lbs. _____ hrs.
Oil _____ bbls., 1st 24 hrs.
Fresh water none recorded feet _____ feet
Salt water none recorded feet _____ feet

Casing and Tubing	Used in Drilling	Left in Well	Packers
Size			Kind of Packer
16			
13			
10	181	Pulled	Size of
8 1/4	934	934	Depth set
6 3/4	1596	1596	
5 3/16	2530	2530	Perf. top
3			Perf. bottom
2	2544	2544	Perf. top
Liners Used			Perf. bottom

CASING CEMENTED _____ SIZE NOT No. Ft. _____ Date _____

COAL WAS ENCOUNTERED AT 458 FEET 84 INCHES
_____ FEET _____ INCHES _____ FEET _____ INCHES
_____ FEET _____ INCHES _____ FEET _____ INCHES

Formation / Color	Hard or Soft	Top	Bottom	Oil, Gas or Water	Depth Found	Remarks
Pittsburgh Coal		458	465			
Dunkard		930	960			
Salt sand		1300	1380			
Little Lime		1600	1610			
Pencil cave		1610	1620			
Big Lime		1620	1670			
Big Injun		1670	1910			
Fifty foot		2260	2305			
Red rock		2315	2370			
Stray		2495				
Gordon		2525		gas	2527	
Total depth			2543			

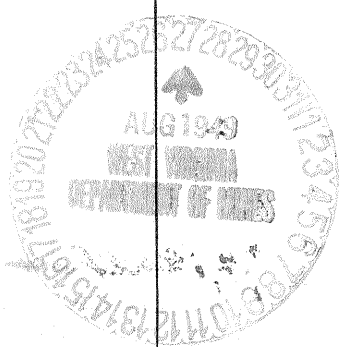

Formation	Color	Hard or Soft	Top	Bottom	Oil, Gas or Water	Depth Found	Remarks

Date August 26, 1949., 19

APPROVED Hope Natural Gas Company., Owner

By C. H. Tollefson

(Title) Superintendent