

865-A	S 1.68
# 5273	W 3.42
# 304	S 1.32
	W 3.25
# 5905	S 1.51
	W 3.01

Map Sheet 39 Squares N9W1FB.526 P3-7

Company Hope Natural Gas Co.
 Address Clarksburg, W. Va.
 Farm Lucius Hoge
 Tract _____ Acres 532 Lease No. 432
 Well (Farm) No. _____ Serial No. See Above
 Elevation (Spirit Level) See Above
 Quadrangle Littleton
 County Wetzel District Grant
 Engineer Tom Sewer
 Engineer's Registration No. 900
 File No. _____ Drawing No. _____
 Date 8-15-50 Scale 1"=800'

STATE OF WEST VIRGINIA
 DEPARTMENT OF MINES
 OIL AND GAS DIVISION
 CHARLESTON

WELL LOCATION MAP
 FILE NO. Wet-865-A

+ Denotes location of well on United States Topographic Maps, scale 1 to 62,500, latitude and longitude lines being represented by border lines as shown.
 - Denotes one inch spaces on border line of original tracing.



STATE OF WEST VIRGINIA
DEPARTMENT OF MINES
OIL AND GAS DIVISION

1315

WELL RECORD

Permit No. Wet-865-82

Oil or Gas Well _____
(KIND)


Company Hope Natural Gas Company.
Address 445 West Main St Clarksburg, W. Va.
Farm Lutius Hoge. Acres 532
Location (waters) _____
Well No. 5273 Elev. 1248
District Grant County Wetzel
The surface of tract is owned in fee by _____
Address _____

Casing and Tubing	Used in Drilling	Left in Well	Packers
Size			Kind of Packer
16			
13			
10	520	Pulled	Size of
8 3/4	1525	Pulled	
6 5/8	2177	2177	Depth set
5 3/16	3030	Pulled	
3			Perf. top
2	3076	3076	Perf. bottom
Liners Used			Perf. top
			Perf. bottom

Mineral rights are owned by _____
Address _____
Drilling commenced December 26, 1918
Drilling completed February 28, 1919
Date Shot _____ From _____ To _____
With _____
Open Flow _____ /10ths Water in _____ Inch
_____ /10ths Merc. in _____ Inch
Volume _____ Cu. Ft.
Rock Pressure _____ lbs. _____ hrs.
Oil _____ bbls., 1st 24 hrs.
Fresh water 160 feet _____ feet
Salt water 1855 feet _____ feet

CASING CEMENTED NOT SIZE _____ No. Ft. _____ Date _____
COAL WAS ENCOUNTERED AT 468 FEET 60 INCHES
944 FEET 48 INCHES FEET INCHES
FEET INCHES FEET INCHES

Formation	Color	Hard or Soft	Top	Bottom	Oil, Gas or Water	Depth Found	Remarks
Coal			468	473	Water	160	
Pitts. Coal			944	948			
Big Dunkard			1480	1490			
Gas sand			1600	1670			
First Salt			1835	1915	water	1855	
Second Salt			1925	2000			
Little Lime			2120	2130			
Pencil cave			2130	2140			
Big Lime			2140	2190			
Big Injun			2190	2452			
Berea			2570	2605			
Gantz			2630	2665			
Gordon stray			3001	3018	gas show	3001	
Gordon			3018	3042	gas	3022	
Total depth				3076			

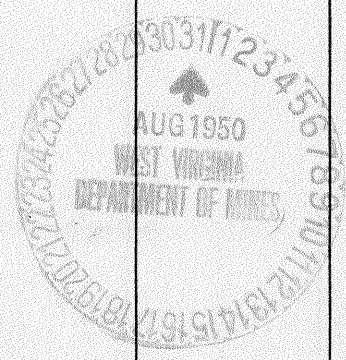

Formation	Color	Hard or Soft	Top	Bottom	Oil, Gas or Water	Depth Found	Remarks

Date August 30, 1950., 19

APPROVED Hope Natural Gas Company., Owner

By E. H. Tolletson

(Title) Superintendent