

Name of present land owner
 Address
 No. of Wells drilled, from top

867-A	S	5.12
#2	W	1.78
868-A	S	5.38
#4	W	1.87

New Location...
 Drill Deeper...
 Abandonment...

Company Quaker State Oil Refining Corp.
 Address Parkersburg, West Va.
 Farm 1000
 Tract 100 Acres 100 Lease No. 100
 Well (Farm) No. 2 Serial No. 4
 Elevation (Spirit Level) 1000 - 1091 feet
 Quadrangle 1111000
 County Wayne District Center
 Engineer J. M. Cochran
 Engineer's Registration No. CO: Surveyor
 File No. _____ Drawing No. _____
 Date Aug. 27, 1911 Scale 400' = 1"

STATE OF WEST VIRGINIA
 DEPARTMENT OF MINES
 OIL AND GAS DIVISION
 CHARLESTON

WELL LOCATION MAP
 FILE NO. Wet-867-A-#2
Wet-868-A-#4

+ Denotes location of well on United States Topographic Maps, scale 1 to 62,500, latitude and longitude lines being represented by border lines as shown.
 - Denotes one inch spaces on border line of original tracing.



1331

STATE OF WEST VIRGINIA
DEPARTMENT OF MINES
OIL AND GAS DIVISION

WELL RECORD


Permit No. 868-A Oil or Gas Well _____ (KIND)

Company Quaker State Oil Refining Corp.
 Address Box 1789 Parkersburg, W. Va.
 Farm J. L. GARNEY Acres 271
 Location (waters) _____
 Well No. 4 Elev. _____
 District Center County Wetzel
 The surface of tract is owned in fee by Webster Henderson
 Address RFD Hundred, W. Va.
 Mineral rights are owned by _____
 Address _____
 Drilling commenced Jan. 22, 1901
 Drilling completed March 29, 1901
 Date Shot 4-2-1901 From _____ To _____
 With 4-14-1904
8-16-1915
 Open Flow _____ /10ths Water in _____ Inch
 _____ /10ths Merc. in _____ Inch
 Volume _____ Cu. Ft.
 Rock Pressure _____ lbs. _____ hrs.
 Oil _____ bbls., 1st 24 hrs.
 Fresh water _____ feet _____ feet
 Salt water _____ feet _____ feet

Casing and Tubing	Used in Drilling	Left in Well	Packers
Size			
16			Kind of Packer
13	103'	103'	
10	1312'	1312'	Size of
8 1/4	1575'		
6 1/2	2270'	2270'	Depth set
5 3/16			
3			Perf. top
2			Perf. bottom
Liners Used			Perf. top
			Perf. bottom

CASING CEMENTED _____ SIZE _____ No. Ft. _____ Date _____
 COAL WAS ENCOUNTERED AT _____ FEET _____ INCHES
 _____ FEET _____ INCHES FEET _____ INCHES
 _____ FEET _____ INCHES FEET _____ INCHES

Formation	Color	Hard or Soft	Top	Bottom	Oil, Gas or Water	Depth Found	Remarks
Pittsburgh Coal			992				
Injun			2280	2500			
Gordon			3052				
Pay - Gordon			3053				
Bottom of Gordon			3076				
Total Depth				3077			

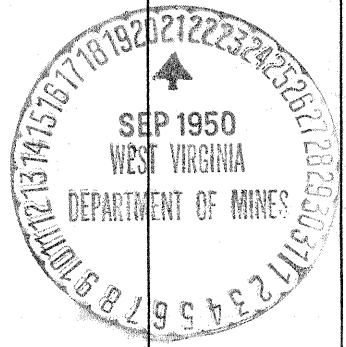

JUN 28 1951