Latitude

Longitude

2.82s 2.15w

Topo Location

7.5' Loc.______ 15' Loc._____ (calc.)

Company Quoto State Rap.

Farm WIV Traggardom #


15' Quad _______(sec.)

7.5' Quad Liltoton

District Center .

WELL LOCATION PLAT

County 103 Permit 30871

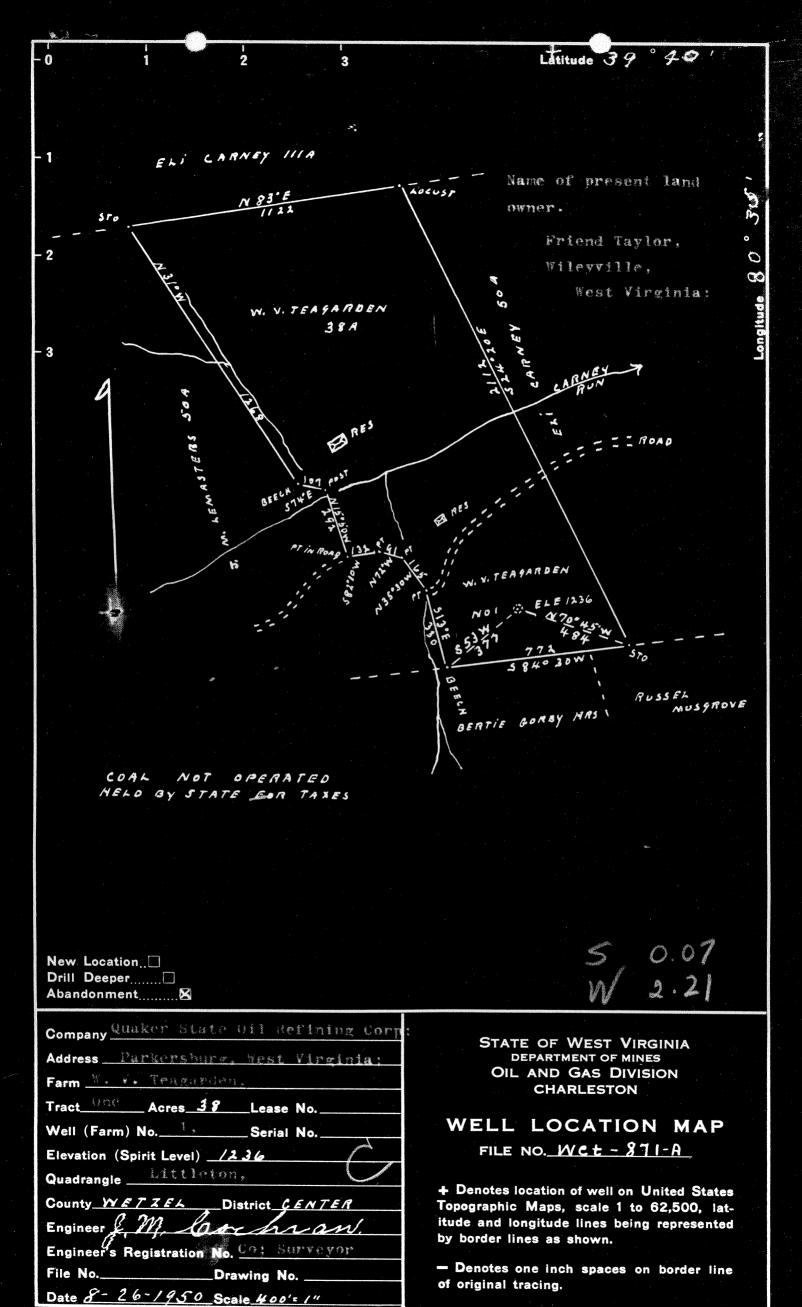

'IMPERIAL" TRACING CLOTE K & E CO., N. Y.