

S 3.59
W 0.56

Surface owned by Lewis Fisher.
 Address: Mr. Lewis Fisher, R.F.D. No. 1, Box No. 10, Smithfield, W. Va.
 Coal owned by Consolidation Coal Co. W. Va.
 Address: O. C. Ankrom, Chief Engineer, Room 800, Watson Building,
 Fairmont, W. Va.

New Location
 Drill Deeper
 Abandonment On 800' Map N59, Sqs. N 6 E 6-7.

Company William Moses
 Address Salem, W. Va.
 Farm W. T. Price
 Tract _____ Acres 34 Lease No. _____
 Well (Farm) No. 6, Serial No. _____
 Elevation (Spirit Level) Floor - 1326.37
Ground - 1326.37
 Quadrangle Littleton
 County Wetzel District Grant
 Engineer Elsworth Haines
 Engineer's Registration No. 2221
 File No. _____ Drawing No. _____
 Date Sept. 16th, 1950. Scale 1" = 400 Feet

STATE OF WEST VIRGINIA
 DEPARTMENT OF MINES
 OIL AND GAS DIVISION
 CHARLESTON

WELL LOCATION MAP
 FILE NO. Wet-811-A

+ Denotes location of well on United States Topographic Maps, scale 1 to 62,500, latitude and longitude lines being represented by border lines as shown.
 - Denotes one inch spaces on border line of original tracing.



STATE OF WEST VIRGINIA
DEPARTMENT OF MINES
OIL AND GAS DIVISION

WELL RECORD

1354

Ab 877-A
Permit No. _____

Oil or Gas Well _____ (KIND)


Company Wm Moses
 Address Salmon, W. Va
 Farm W.Y. Price Acres 34
 Location (waters) _____
 Well No. 6 Elev. 1376.37
 District Grant County Wetzel
 The surface of tract is owned in fee by _____
 Address _____
 Mineral rights are owned by _____
 Address _____
 Drilling commenced 4-9-98
 Drilling completed 5-16-1898
 Date Shot _____ From _____ To _____
 With _____
 Open Flow _____ /10ths Water in _____ Inch
 _____ /10ths Merc. in _____ Inch
 Volume _____ Cu. Ft.
 Rock Pressure _____ lbs. _____ hrs.
 Oil _____ bbls., 1st 24 hrs.
 Fresh water _____ feet _____ feet
 Salt water _____ feet _____ feet

Casing and Tubing	Used in Drilling	Left in Well	Packers
Size			Kind of Packer
16			
13			
10			Size of
8 1/4		1592	
6 5/8		2052	Depth set
5 3/16		2112	
3			Perf. top
2			Perf. bottom
Liners Used			Perf. top
			Perf. bottom

CASING CEMENTED _____ SIZE _____ No. Ft. _____ Date _____

COAL WAS ENCOUNTERED AT 1074 FEET 96 INCHES
 _____ FEET _____ INCHES FEET INCHES
 _____ FEET _____ INCHES FEET INCHES

Formation	Color	Hard or Soft	Top	Bottom	Oil, Gas or Water	Depth Found	Remarks
Coal			1074	1082			
Dunkard			1590	1625			
Salt			1985	2100			
Big Lime			2285	2365			
Big Injun			2373	2462			
Total Depth.				2465			

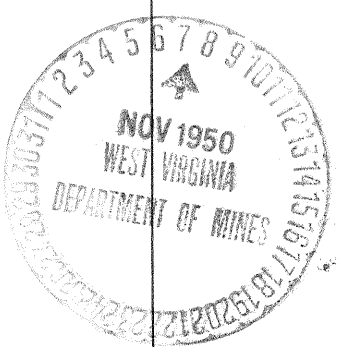

(Over)

NOV 28 1951