

Surface owned by Clyde W. Judge.  
 Address: Mr. Clyde W. Judge, Pine Grove, Wetzel Co. W. Va.  
 Coal owned by Imperial Oil & Gas Products Co.  
 Address: 230. Grant St. Pittsburgh, Pa.

S 5.31  
 W 2.51

New Location...   
 Drill Deeper.....   
 Abandonment.....  On 800' Map N68. Sqs. N10-11 W 1.

Company William Moses  
 Address Salem, W. Va.  
 Farm S. A. Minor  
 Tract \_\_\_\_\_ Acres 150 Lease No. \_\_\_\_\_  
 Well (Farm) No. 2 Serial No. \_\_\_\_\_  
 Elevation (Spirit Level) Floor-- 1035.53  
Ground-- 1034.73  
 Quadrangle Littleton  
 County Wetzel District Grant  
 Engineer Elworth Haines  
 Engineer's Registration No. 2221  
 File No. \_\_\_\_\_ Drawing No. \_\_\_\_\_  
 Date Apr. 21st, 1950 Scale 1" = 800 Feet

STATE OF WEST VIRGINIA  
 DEPARTMENT OF MINES  
 OIL AND GAS DIVISION  
 CHARLESTON

WELL LOCATION MAP  
 FILE NO. Wet-878-A

+ Denotes location of well on United States Topographic Maps, scale 1 to 62,500, latitude and longitude lines being represented by border lines as shown.

- Denotes one inch spaces on border line of original tracing.



STATE OF WEST VIRGINIA  
DEPARTMENT OF MINES  
OIL AND GAS DIVISION

1351

WELL RECORD

Permit No. 878-A Oil or Gas Well X (KIND)


Company Wm Moses  
Address Salem, W. Va.  
Farm S.A. Minor Acres \_\_\_\_\_  
Location (waters) \_\_\_\_\_  
Well No. 2 Elev. \_\_\_\_\_  
District Grant County Wetzel  
The surface of tract is owned in fee by \_\_\_\_\_  
Address \_\_\_\_\_  
Mineral rights are owned by \_\_\_\_\_  
Address \_\_\_\_\_  
Drilling commenced \_\_\_\_\_  
Drilling completed 3/18.1908  
Date Shot \_\_\_\_\_ From \_\_\_\_\_ To \_\_\_\_\_  
With \_\_\_\_\_

Casing and Tubing	Used in Drilling	Left in Well	Packers
Size			
16			Kind of Packer
13			
10			Size of
8 1/4		1239	
6 5/8		2030	Depth set
5 3/16		2082	
3			Perf. top
2			Perf. bottom
Liners Used			Perf. top
			Perf. bottom

Open Flow \_\_\_\_\_ /10ths Water in \_\_\_\_\_ Inch  
\_\_\_\_\_ /10ths Merc. in \_\_\_\_\_ Inch  
Volume \_\_\_\_\_ Cu. Ft.  
Rock Pressure \_\_\_\_\_ lbs. \_\_\_\_\_ hrs.  
Oil \_\_\_\_\_ bbls., 1st 24 hrs.  
Fresh water \_\_\_\_\_ feet \_\_\_\_\_ feet  
Salt water \_\_\_\_\_ feet \_\_\_\_\_ feet

CASING CEMENTED \_\_\_\_\_ SIZE \_\_\_\_\_ No. Ft. \_\_\_\_\_ Date \_\_\_\_\_  
COAL WAS ENCOUNTERED AT 793 FEET 96 INCHES  
\_\_\_\_\_ FEET \_\_\_\_\_ INCHES \_\_\_\_\_ FEET \_\_\_\_\_ INCHES  
\_\_\_\_\_ FEET \_\_\_\_\_ INCHES \_\_\_\_\_ FEET \_\_\_\_\_ INCHES

Formation	Color	Hard or Soft	Top	Bottom	Oil, Gas or Water	Depth Found	Remarks
Coal			793	805			
Big Lime			1987	2030			
Big Injun			2030	2280			
50 Ft.			2540	2565			
Total Depth				2904			

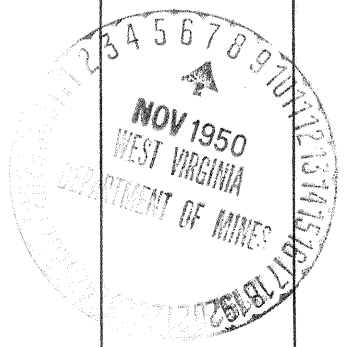

(Over)

NOV 28 1951