Latitude

:470

Topo Location

7.5' Loc.______ 15' Loc._____ (calc.)

Company Hope Nat Gas Co

Farm Blockshene Wells Co #628


15' Quad _______(sec.)

7.5' Quad Folsom

District GRANT

WELL LOCATION PLAT

County 103 Permit 30898

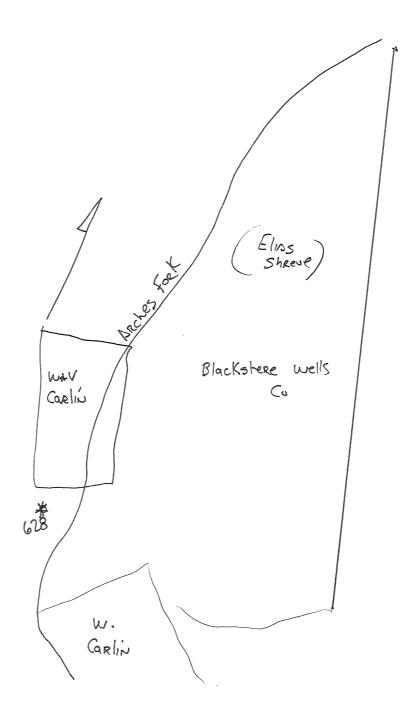



STATE OF WEST VIRGINIA

DEPARTMENT OF MINES

OIL AND GAS DIVISION

WELL RECORD

Oil or Gas Well (KIND) Company Hope Natural Gas Company. Left in Well Casing and Tubing Used in Drilling Packers Address 445 West Main St. Clarksburg W. Va. Farm Blackshere Wells Co. Acres 3550 Size Location (waters)__ Kind of Packer_ 16____ Well No. 628 _Ele**v. 1064** 13____ District Grant County Wetzel Size of_ The surface of tract is owned in fee by-1320 81/4___ 1320 __Address__ Depth set___ 21.26 Mineral rights are owned by___ 5 3/16___ 2952 2952 _Address_ Drilling commenced June 24, 1904 Perf. top___ Perf. bottom___ Drilling completed August 13, 1904 Perf. top_ Liners Used_ Date Shot_ _From___ Perf. bottom_ With_ /10ths Water in___ Inch Open Flow not __/10ths Merc. in___ CASING CEMENTED_ SIZE No. Ft.____ Date _Inch _Cu. Ft. Rock Pressure___ _hrs.

Salt water	one record		feet	FEET FEET		S FEET S FEET	* 4
Formation	Color	Hard or Soft	Тор	Bottom	Oil, Gas or Water	Depth Found	Remarks
	tsburgh Co kard	2	799 1290	803 1330			
Sal	t sand		1590	1838			
Wax	o n		1994	5010			
Bie	Lime		2070	21.25		Constant of the Constant of th	
P4.6	Inju		21.25	2257			
	ty lost		2663	2690			
Gor	don		2919	2926	888	2920	
Tot	al depth			29 52			
		ANTER CONTRACTOR OF THE PROPERTY OF THE PROPER					
							•
		· ·					
					·		
	* #			())			
	197	·	2527282	3037773			
			10	SAMP OF ST			
			187.7.2. 18 18 18 18 18 18 18 18 18 18 18 18 18	M. Or William 2	Programme (1)		· · · · · · · · · · · · · · · · · · ·
			SENTING SERVING	CHILD S			
		• ,	<9191p	CLERY	er en		

(Over)

Formation	Color	Hard or Soft	Тор	Bottom	Oil, Gas or Water	Depth Found	Remarks
·			• .				
•							
						,	- "M"
							y
				,			
					. AV		
		· ·			ur mandani de la companio del companio de la companio de la companio del companio de la companio del la companio de la compani		
				#**			
•	the state of the s						
			Table and table				
	The state of the s			The state of the s			t .
	- Company of the Comp						
		·					,
				A Company		The second secon	
	~						
						The second secon	
		* .					
		*					
	. I	1			Russi	ril 25, 1951	
				APPROVED		Gas Company	, 19, , Owner

Ву____

MATHEWS PRINTING AND LITHOGRAPHING CO

_, Owner