Longitude

2.54s 1.84w

Latitude

Topo Location

7.5' Loc.______ 15' Loc._____ (calc.)

Company Quaker State Oil Ref. Corp

Farm Eli Canmay #1


15' Quad _______(sec.)

7.5' Quad Littleton

District Center

WELL LOCATION PLAT

County 103 Permit 30899

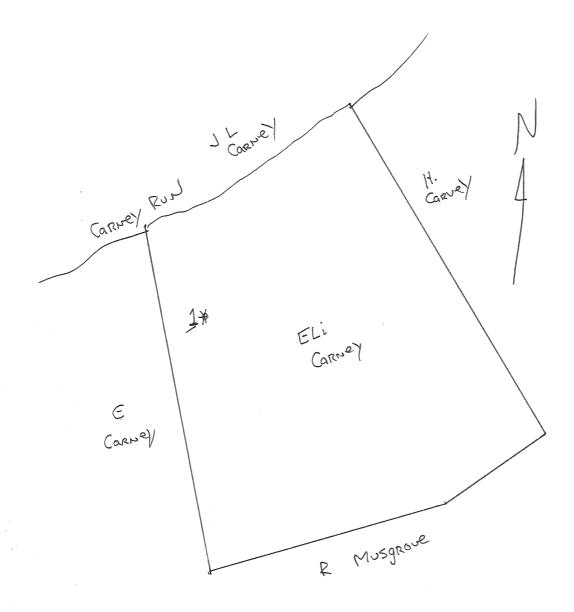



STATE OF WEST VIRGINIA

DEPARTMENT OF MINES

OIL AND GAS DIVISION



Well No.

WELL RECORD

Oil or Gas Well Company Quaker State Oil Refining Corporation Casing and Tubing Used in Drilling Left in Well Packers Address Box 1789 Parkersburg, W. Va. E**li** Carney 56 Size Location (waters) Carney Run Kind of Packer 16_ Elev. 1,251 150 Pulled OWS Center __County_Wetzel 760 Size of 5-3/16 1510 The surface of tract is owned in fee by Charles Metz Pulled Address Silver Hill W. Va. 81/4_ 1946 Depth set 2464 2382 2382 6%_ Mineral rights are owned by_ 2464 2464 5 3/16_ __Address_ Perf. top_ Drilling commenced December 27, 1900 Drilling completed March 12, 1901 3247 3247 Perf. bottom_ Date Shot 6/25/14 From__ Liners Used Perf. top_ 90 ats.

With90	qts.	And the second s				P	erf. bottom	
Open Flow	·	in		Exercise Control Contr	I I			
	•	in		CASING CEMI	ENTED	.SIZENo	. FtDate	
		lbs				** ** ***		
Oil Oil				COAL WAS ENCOUNTERED AT 1,193 FEET INCHES				
Fresh waterfeetfeet								
Salt water		feet	feet	FEE	rINC	HESFE	ETINCHES	
Formation	Color	Hard or Soft	Тор	Bottom	Oil, Gas or Water	Depth Found	Remarks	
Pittsburgh Coal			1193	කත මට බොද ගියි				
Big Injun Gordon			2435 3223	2650	Oil Oil	3220 32 37	Small Best	
Total Depth				3247				
				2029303 2000 -	172345			
				i Will William	WA 3			
				DEPARTMENT OF	Marie 2			
		35 cd 2						
ander og e Light Star Star		Charles Charle				1 1 1 1 1 1 1 1 1 1 1 1 1 1 1 1 1 1 1	A STATE OF THE STA	

Formation	Color	Hard or Soft	Тор	Bottom	Oil, Gas or Water	Depth Found	Remarks
· · · · · · · · · · · · · · · · · · ·	AAN PER PETUTE BERKEREN BERKEREN BEGEN STOREN ER BERKEREN BESTELLE BESTELLE BESTELLE BESTELLE BESTELLE BESTELLE	Mina di Birkhow warning in Safaka ana Anna Anna Anna Anna ang manang manang manang manang manang manang manang 	MARTINATION (ENGLIS) INVESTIGATION AND AND AND AND AND AND AND AND AND AN	MERINGORIA ZIRICARAN CETTANIA GALAMAKAN TETANIA KAMPUNTAN TANIH MENINGAN KAMPUNTAN KAM	WERT ARTHUR STEEL AND ACCOUNTED SAFE CONTRIBUTIONS AND THE CONTRIBUTION ASSESSMENT AND ACCOUNTED SAFE CONTRIBUTION ASSESSMENT ASSESSMENT ASSESSMENT ASSESSMENT ASSESSMENT ASSESSMENT ASSESSMENT ASSESSMENT ASSESSMENT ASSES	MEM (MONIO) MEMORY (MEMORY NATIONAL) SHOWN HELD WAS AN AREA SET ON MEMORY AND	ersectives and the department of the second
		,					
w _y							
			N.	·			
				,			
							•
-							
				a granda men	A STATE OF THE STA		
en e							
							American de la companya del companya del companya de la companya d
						in the second second	
• **				%		See Market	
	Lagy	122	-				
					West and the second		
	*						
							Marine Services
					en jary-		
•				e Maria esta engonografia	Sec. 14 Sept. March Sec.	Confession for the forest sections	
			è				
	er.						
		, · · · · · · · · · · · · · · · · · · ·					
						A Company of the Comp	

APPROVED GUAKER STATE OIL REFINING CORPORATION WINE By H. F. Johnston (Title) Dist. Geologist.