Latitude

Topo Location

7.5' Loc.____ 15' Loc. (calc.)

Company Interstate Pipe + Supply Co

Farm Brast Bros. #20


15' Quad ____ (sec.)

7.5' Quad Folsom

District ____ GRANT

WELL LOCATION PLAT

County 103 Permit 30900

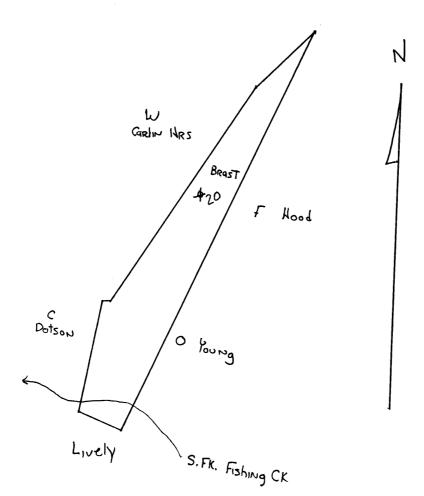



STATE OF WEST VIRGINIA

DEPARTMENT OF MINES

OIL AND GAS DIVISION

WELL RECORD

(KIND) Company The Interstate Pipe & Supply Company Casing and Tubing Used in Drilling Left in Well Packers Address P. O. Box 548, Marietta, Ohio Farm Brast Brothers 50.63 Size Location (waters) Kind of Packer 16. Elev. 1390.34 Well No. 13_ District Grant Wetzel _Countv__ 8270 31 none The surface of tract is owned in fee by F. S. Hood 10_ 17591 9" 17591 9" 318 Second Street Address Marietta, Ohio 81/4_ 24231 7" 24231 711 Mineral rights are owned by State of West Virginia Depth set 2755'11" 2755'11" AddressCharleston, W.Va. 5 3/16_ Drilling commenced 3/31/98 Perf. top_ Drilling completed 6/24/98 Perf. bottom. то 3315 Perf. top. From 3314 Liners Used Date Shot_

With						Perf. bottom		
-	•	in		<u> </u>	,	•		
	•	in	,	CASING CEME	NTEDSIZ	ZENo. Ft	Dat	
							· · · · · · · · · · · · · · · · · · ·	
		lbs		COAL WAS EN	COUNTERED A	1194 FEET	72 INCHE	
			•	•				
		feet					1	
Salt water	I		feet	FEE1			INCHE	
Formation	Color	Hard or Soft	Тор	Bottom	Oil, Gas or Water	Depth Found	Remarks	
Conductor Pittsburgh C Dunkard Sand Salt Sand Big Lime Pencil Cave Big Injun Sa Gantz Sand Pifty Foot Stray Sand Gordon Sand Gas lst Pay Oil	÷.		1194 1690 2084 2397 2390 2498 3250 3190 3284 3310 3320 3315	16 1200 1725 2290 2498 2397 2650 3270 3220 3295 3322				
Total	13. 15. 21. 28. 28. 28. 28. 28. 28. 28. 28. 28. 28	MAY 1951 WEST VIRGINIA EPARTMENT OF MINES	8 9 101172 13 A	3337				

Formation	Color	Hard or Soft	Тор	Bottom	Oil, Gas or Water	Depth Found	Remarks
•							
					·		
				į.			·
						•	
			·				
							·
						, # ¹	
		,		. '			
				·			
	-						
							·
					į,		
					í		
	_		,				
4 v		-	·				
						٠.,	
				·			
					Date Ms	y 2	, 19 .51

	Date Ma	y 2		,	19.51.
APPROVED	INTERSTATE	PIPE &	SUPPLY	COMPANY	. Owne

By Adolph Berew (Title) 9

MATHEWS PRINTING AND LITHOGRAPHING C