

New Location...
 Drill Deeper...
 Abandonment... 1567

NOV 21 1953
 MAP Sh. 45 S1 E 4 FB 562 P 18-21

Company Hope Natural Gas Co.
 Address Clarksburg, W.Va.
 Farm Catherine Carlin
 Tract _____ Acres 335 Lease No. 18765
 Well (Farm) No. _____ Serial No. As Shown
 Elevation (Spirit Level) As Shown
 Quadrangle Centerpoint
 County Wetzel District Grant
 Engineer Wm Powers
 Engineer's Registration No. 900
 File No. _____ Drawing No. _____
 Date 4-28-51 Scale 1" = 40 P

STATE OF WEST VIRGINIA
 DEPARTMENT OF MINES
 OIL AND GAS DIVISION
 CHARLESTON

WELL LOCATION MAP
 FILE NO. Wet - 901-A - # 1567
Wet - 995-A - # 5318

+ Denotes location of well on United States Topographic Maps, scale 1 to 62,500, latitude and longitude lines being represented by border lines as shown.
 - Denotes one inch spaces on border line of original tracing.



STATE OF WEST VIRGINIA
DEPARTMENT OF MINES
OIL AND GAS DIVISION

1337

Imp.
Ab 901-A - Plat 995

WELL RECORD

Permit No. _____ ~~Oil~~ Gas Well _____ (KIND)


Company Hope Natural Gas Company.
 Address 445 West Main St. Clarksburg, W. Va.
 Farm Catherine Carlin Acres 335
 Location (waters) _____
 Well No. 1567 Elev. 1347
 District Grant County Wetzel
 The surface of tract is owned in fee by _____
 Address _____
 Mineral rights are owned by _____
 Address _____
 Drilling commenced November 12, 1909
 Drilling completed January 19, 1910
 Date Shot _____ From _____ To _____
 With _____
 Open Flow _____ /10ths Water in _____ Inch
 _____ /10ths Merc. in _____ Inch
 Volume _____ Cu. Ft.
 Rock Pressure _____ lbs. _____ hrs.
 Oil _____ bbls., 1st 24 hrs.
 Fresh water none recorded feet _____ feet
 Salt water none recorded feet _____ feet

Casing and Tubing	Used in Drilling	Left in Well	Packers
Size			Kind of Packer
16			
13			
10	342	Pulled	Size of
8 1/4	1528	1528	
6 3/8	2308	2308	Depth set
5 3/16	2682	2682	
3			Perf. top
2	3345	3345	Perf. bottom
Liners Used			Perf. top
			Perf. bottom

NOT
 CASING CEMENTED _____ SIZE _____ No. Ft. _____ Date _____
 COAL WAS ENCOUNTERED AT **1060** FEET **84** INCHES
 _____ FEET _____ INCHES _____ FEET _____ INCHES
 _____ FEET _____ INCHES _____ FEET _____ INCHES

Formation	Color	Hard or Soft	Top	Bottom	Oil, Gas or Water	Depth Found	Remarks
Pittsburgh Coal			1060	1067			
Little Dunkard			1436	1475			
Big Dunkard			1555	1590			
Gas sand			1690	1715			
Salt sands			1895	1950			
Little Lime			2280	2312			
Big Lime			2316	2376			
Big Injun			2376	2501	gas	2462	
Gordon stray			3120	3150	gas	3140	
Gordon			3170	3175			
Fourth			3180	3186			
Total depth				3345			

Formation	Color	Hard or Soft	Top	Bottom	Oil, Gas or Water	Depth Found	Remarks

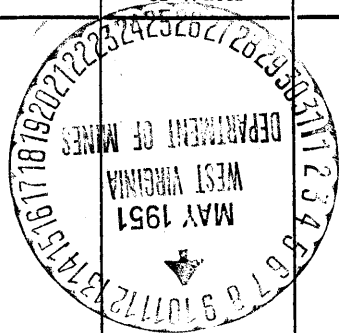

Date May 9, 1951, 19

APPROVED Hope Natural Gas Company., Owner

By _____ (Title)