Latitude

1.94s

Topo Location

7.5' Loc	15' Loc
	(calc.)

Company Hope Nat. Gas


Farm Jocob Brost # 10

7.5' Quad Pine Grove

District Green

WELL LOCATION PLAT

County 103 Permit 30904

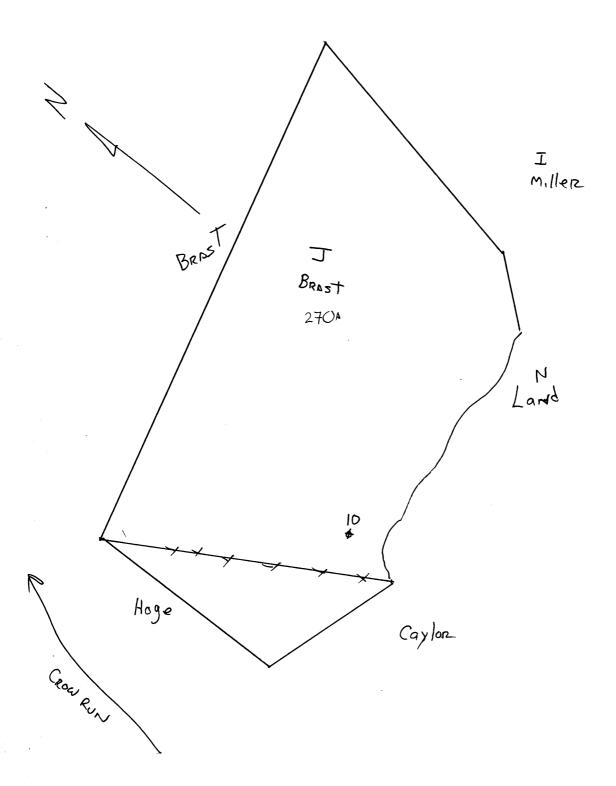





DEPARTMENT OF MINES

OIL AND GAS DIVISION

WELL RECORD

(138)

Qibor Gas Well (KIND) Company HOPE NATURAL GAS COMPANY Used in Drilling Left in Well Casing and Tubing **Packers** Address 445 West Main St. Clarksburg, W. Va. Jacob Brast Farm_ Size Location (waters). Elev. 1389 Kind of Packer. 16_ Well No... _County_Wetzel 13_ District Green Pulled 700 Size of. The surface of tract is owned in fee by Pulled 1550 81/4. 2612 2616 Depth set. 6% Mineral rights are owned by_ Drilling commenced May 21, 1898 5 3/16_ Perf. top.

Drilling completed December 3, 1898			2	3232	3232	Perf. bottom	
Date Shot From To			Liners Used	-		Perf. top	
With					_		Perf. bottom
Open Flow	•	in			ENTED	NOT SIZE	No. Ft. Dat
	•						
Rock Pressure		lbs	hrs.		ENCOUNTERED	1115	FEET ? INCHE
Oil	<u> </u>		_bbls., 1st 24 hrs.				
Fresh water 10	ne recorde	<u>d</u> feet	feet	FEE	TINCH	IES	FEETINCHES
Salt waterno	ne recorde	dfeet	feet	FEF	TINCH	IES	FEET INCHE
Formation	Color	Hard or Soft	Тор	Bottom	Oil, Gas or Water	Depth Found	Remarks
Pittsbur	Coal		1115	1122 Est			
Big Inju			2400	2595			
Gordon s	tray		31.64	31.84	gas	3163	
Gordon	-		3192	3196	show oil	31.96	
Total de	pth			3 23 2			
				•			
					147		
							4
							4
	,						3
	,						
		1319	15167770			1 1	
		The state of the s		•		,	
	7.	M. M.	MY 1951				
		NES WES	MY 1951 S	# 1 1			
		DEPARTM	AY 1951 VIRGINIA WITH OF MINES				
		15	I "IIIIE)	· · · · · · · · ·			
		(E)	1 200				18.5
			15050000	*			788
							•
					•		

Date. Key 7, 1951 Date. Key 7, 1951 APPROVED Hope Natural Cas Company. Owner Owner	Formation	Color	Hard or Soft	Тор	Bottom	Oil, Gas or Water	Depth Found	Remarks
May 7, 1951								
16y 7, 1951			ły:					
16y 7, 1951				·		·		
16y 7, 1951								
16y 7, 1951		·	7		,			
16y 7, 1951								
16y 7, 1951	·		,					
16y 7, 1951								
16y 7, 1951							. =	
16y 7, 1951								
16y 7, 1951						·		
16y 7, 1951								
16y 7, 1951			·					
16y 7, 1951								
16y 7, 1951								
16y 7, 1951								4
May 7, 1951			,					
May 7, 1951								
May 7, 1951								
May 7, 1951								
May 7, 1951				,				
May 7, 1951								
May 7, 1951			·					
May 7, 1951	* ************************************			1				
May 7, 1951								
May 7, 1951 Date			,				1	
Date May 7, 1951 , 19			,					
Date 7, 1951 , 19 APPROVED Hope Natural Gas Company. Owner						,		
Date 1951 APPROVED Hope Natural Gas Company. Owner						and the second s	a contract of the second	
Date 7, 1951 APPROVED Hope Natural Gas Company, Owner								
Date								
Date 7, 1951 , 19 APPROVED Hope Natural Gas Company. Owner			*	¥.				,
Date 1951 , 19 APPROVED Hope Natural Gas Company. Owner								
Date Hope Natural Gas Company. APPROVED Hope Natural Gas Company. Owner								
Date 7, 1951 , 19								
APPROVED Hope Natural Gas Company, Owner						Date	7, 1951	, 19
					APPROVED_	lope Natural	Gas Company,	Owner (Color)

STATHEWS PRINTING AND LITHOGRAPHING CO

(Tity) Ву____

__, Owner