


30911

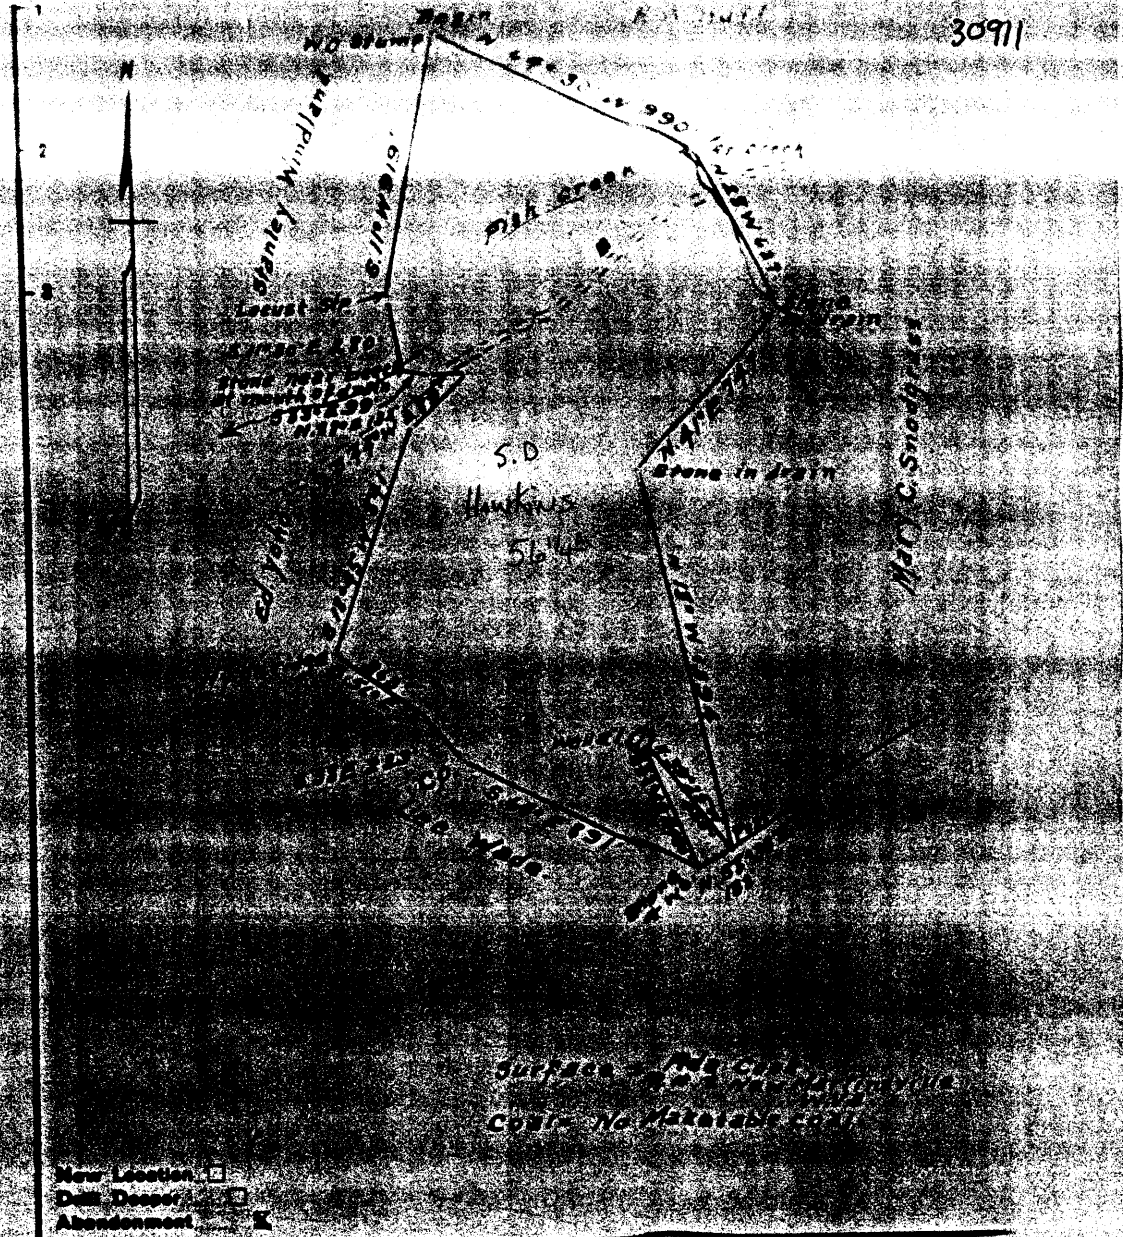

Surface - *see map*
 Cont. No. *see map*

New Location
 Drill Deeper
 Abandonment

Company A. H. Sinder
 Address 427 1st Ave. Waynesburg Pa
 Farm S. D. Hawkins
 Tract Area 564 Tract No. _____
 Well (Farm) No. 1 State No. _____
 Direction (Side) 1065
 Diameter New Martinsville
 County Wayne State OHIO
 Name A. H. Sinder

STATE OF WEST VIRGINIA
 DEPARTMENT OF MINES
 OIL AND GAS DIVISION
 CHARLESTON

WELL LOCATION M
 FILE NO. 1065-711-A

This document is a part of the United States Geological Survey's Oil and Gas Survey and is available for public use.

