

39° 32' 30"

Latitude

80° 42' 30"

Longitude

⊕
1.82s
1.03w

Topo Location

7.5' Loc. _____ 15' Loc. _____
_____ (calc.) _____

Company Hope Nat Gas

Farm Lucius Hoge # 5402


15' Quad _____
(sec.)

7.5' Quad Pine Grove

District Green

WELL LOCATION PLAT

County 103 **Permit** 30930

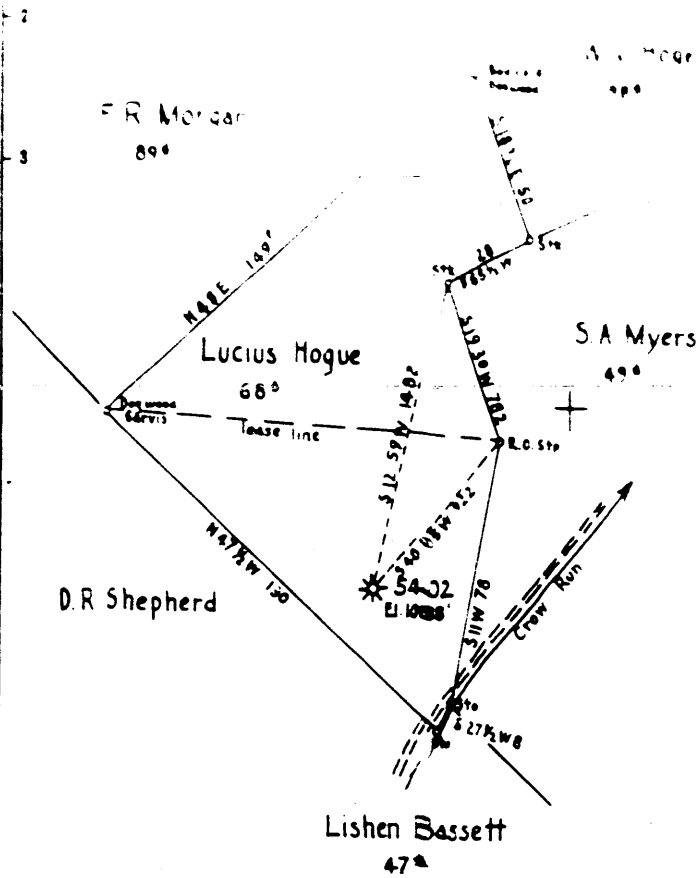

New Location
 Drill Deeper
 Abandonment

Sh. 46 N5 W6 FB 1005 P. 34

Company	HOPE NATURAL GAS CO.	
Address	CLARKSBURG, W. VA.	
Form	LUCIUS HOGUE	
Treat	Acres 33	Lease No. 23737
Well (Farm) No.	Serial No. 5A-22	
Elevation (Spitts Level)	1088	
Quadrangle	LITTLETON	
County	WETZEL	District GREEN
Engineer	<i>Wm. Bowers</i>	

STATE OF WEST VIRG.
 DEPARTMENT OF MINE.
 OIL AND GAS DIVISION
 CHARLESTON

WELL LOCATION
 FILE NO. WET-93

+ Denotes location of well on U.S. Topographic Maps, scale 1 to 6 miles and longitude lines being

Name: MADE SALINE
 Address: MADE SALINE
 Farm: MADE SALINE
 Location: Water
 Well No: 30930
 District: Green
 The surface of tract is owned in fee by A
 Mineral rights are owned by A
 Drilling commenced: Mar 24 1918
 Drilling completed: May 2 1918
 Date Shot: From
 With: _____
 Open Flow: 10ths Water in
 Volume: _____
 Rock Pressure: _____
 Oil: _____
 Fresh water: 2020
 Salt water: 1800

Feet	Loss to Drilling	Loss to Well	Partners
0			
10			
14	2137	640	
20	2010	2010	Depth out
23 1/2	2044	2044	
2			Perf top
1	2082	2082	Perf bottom

Casing CEMENTED _____ SIZE _____ No Ft. _____ Date _____
 COAL WAS ENCOUNTERED AT 325 FEET 24 INCHES
535 FEET 2 INCHES TO 700 FEET 24 INCHES
FEET INCHES FEET INCHES

Formation	Color	Top	Bottom	Oil, Gas or Water	Depth Found	Remarks
Coal		325	327			
Coal		535	538			
Coal		700	702			
Little Dunkard		1160	1250			
Big Dunkard		1290	1345			
Gas sand		1360	1420			
First Salt		1518	1575			
Second Salt		1612	1663			
Third Salt		1700	1854	water	1800 hole full	
Mazon		1888	1926			
Little Lime		1968	1982			
Pencil cave		1982	1987			
Big Lime		1987	2083	water	2020	
Big Injun		2083	2300	Gas	2177	
Gordon		2852	2877	gas	2853 2872	
Total depth			2880			

1951
 MADE SALINE
 GREEN DISTRICT

STATE INSPECTOR

STATE OF WEST VIRGINIA

County of Boone

being first duly sworn, deponent do hereby depose and say that the work of plugging and filling said well was done by the said workmen and the well operator and that the work of plugging and filling said well was commenced on the 17th day of September 1951 and that the well was plugged and filled in the following manner:

SAND OR SOLE RECORD	FOUNDATION	CONTENT	NO MATERIAL		PIEGS USED	CASING	
			FEET	TO		SIZE & NO.	COB PULLED LEFT IN
Native Sand	225-227	Gravel	280	280		8-5/8"	
Maple Grove	700-702	Cement	273	273		None	640'
Little Duck	1160-1150	Gravel	274	288			
Big Duckard	1290-1345	Bridge-		2800		7"	
Gas Sand	1360-1420	Gravel	2800	2000		988'	1012'
1st Salt	1518-1575	Cement	2900	1990			
2nd Salt	1612-1663	Cement	1990	1700		5 1/2"	
3rd Salt	1700-1854	Cement	1700	1390		1980'	65'
Maxon	1988-1926	Bridge		300			
Little Lime	1968-1982	Gravel	290	732		2-1/8" Tubing	
Pencil Cave	1932-1967	Cement	732	680		2753'	129'
Big Lime	1987-2083	Gravel	580	567			
Injun	2083-2300	Cement	567	515			
Squaw	2310	Gravel	515	357			
Grantz	2540	Cement	357	305			
Fifty Feet	2640-2700	Gravel	305	100		DESCRIPTION OF MONUMENT	
30 ft.	2760-2800	Gravel		100		Erected concrete well marker	
Gordon	2852-2877	Clay & Rock	90	Surface		over top of hole marked H.W.C.Co.	
Total Depth	2880	Installed plug at 2753'				Well # 8402.	
		Instead of 2832 w/d could				not pull all of casing.	

and that the work of plugging and filling said well was completed on the 17th day of September 19 51

And further deponents saith not

Sworn to and subscribed before me this 25 day of October 1951.

My commission expires

1951

Notary Public