Latitude

80°35′00"

Longitud

Topo Location

.93w

7.5' Loc._____ 15' Loc.____ (calc.)

Company Valley Steel Prods

Farm John Mills + 1


15' Quad _______(sec.)

7.5' Quad Big Run

District GRANT


WELL LOCATION PLAT


County 103 Permit 30935

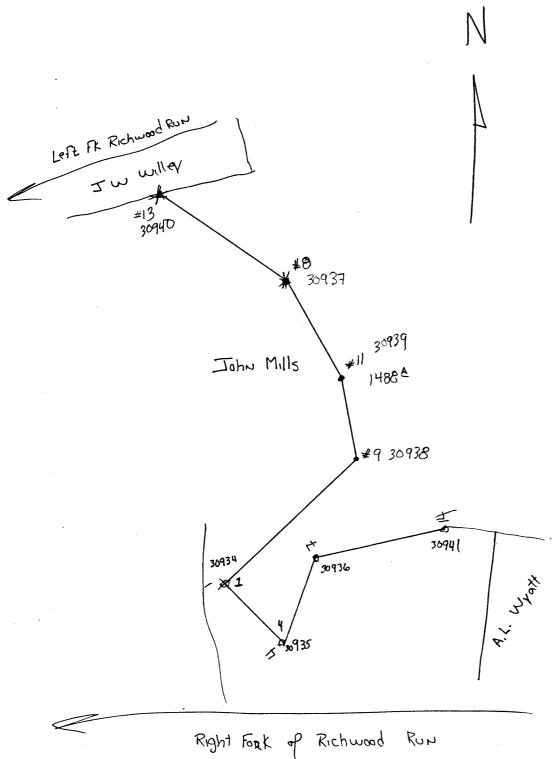



STATE OF WEST VIRGINIA DEPARTMENT OF MINES OIL AND GAS DIVISION

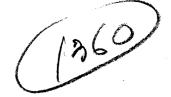

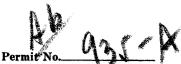

Company_

Address_

Well No.

District 1

Drilling completed____

Date Shot_

With.... Open Flow

Volume_

Rock Pressure_

Fresh water_

Mineral rights are owned by_

WELL RECORD

(KIND) Used in Drilling Left in Well Valley Steel Products Co. Casing and Tubing Packers St. Louis, No. John Mills Acres_ 1486 Location (waters) Right & Left Fork Richwood Run Kind of Packer___ Elev. 965 Size of_ Pulled 10_ The surface of tract is owned in fee by. 1385 Pulled 81/4. _Address 2075 Depth set_ 5 3/16_ Address Perf. top__ 6" casing & Drilling commenced 2" Tubin in hole Perf. bottom_ Sept. 16, 1916 Perf. top_ Liners Used_ From Perf. bottom. /10ths Water in_ Inch CASING CEMENTED_ SIZE No. Ft. Date __/10ths Merc. in__ _Inch _Cu. Ft. _lbs._ _hrs. COAL WAS ENCOUNTERED AT_ FEET_ INCHES _bbls., 1st 24 hrs. FEET INCHES THET. INCHES feet feet INCHES FEET INCHES

Salt water		feet	feet	;FEE'	rinche	SFEET	INCHE
Formation	Color	Hard or Soft	Тор	Bottom	Oil, Gas or Water	Depth Found	Remarks
Conductor Native Cos Pittsburg	1		14 330 818	887		Constant of the second	
fied Books	and the same of th		1875	75/0	The state of the s		R. T. C.
lat Cow R						The state of the s	
let Salt	end		1625	1040	Water	de compresso con la compresión de la compre	
3rd Salt 3 Maxon Big Lime	and		1982	1948 2028 2090	Reduced	hole at 20	7 5
Reener Sar Pay Sand Injun Sand Squar			5080 5100 5080	2111	Gas gaug	3,800,00)
Games Pifty Foot Red Rook			2698 2846				
Gordon Gordon Fourth Sa		Market Control of the	2907	5576	Oil and a Bottom of	as Cordon sa	14 2920
Fifth San Total Dep				2925			
No rig he	re, outfi	t fell down					
Dunn Mar	never pr	duced	K	189107772			
				S. N.			