

39° 42' 30"

Latitude

80° 35' 00"

⊕
.575
.90w

Longitude

Topo Location

7.5' Loc. _____ 15' Loc. _____
_____ (calc.) _____

Company Valley Steel Prod

Farm Jacob Long #1 - 6459


15' Quad _____
(sec.)

7.5' Quad Littleton

District Center

WELL LOCATION PLAT

County 103 Permit 30942

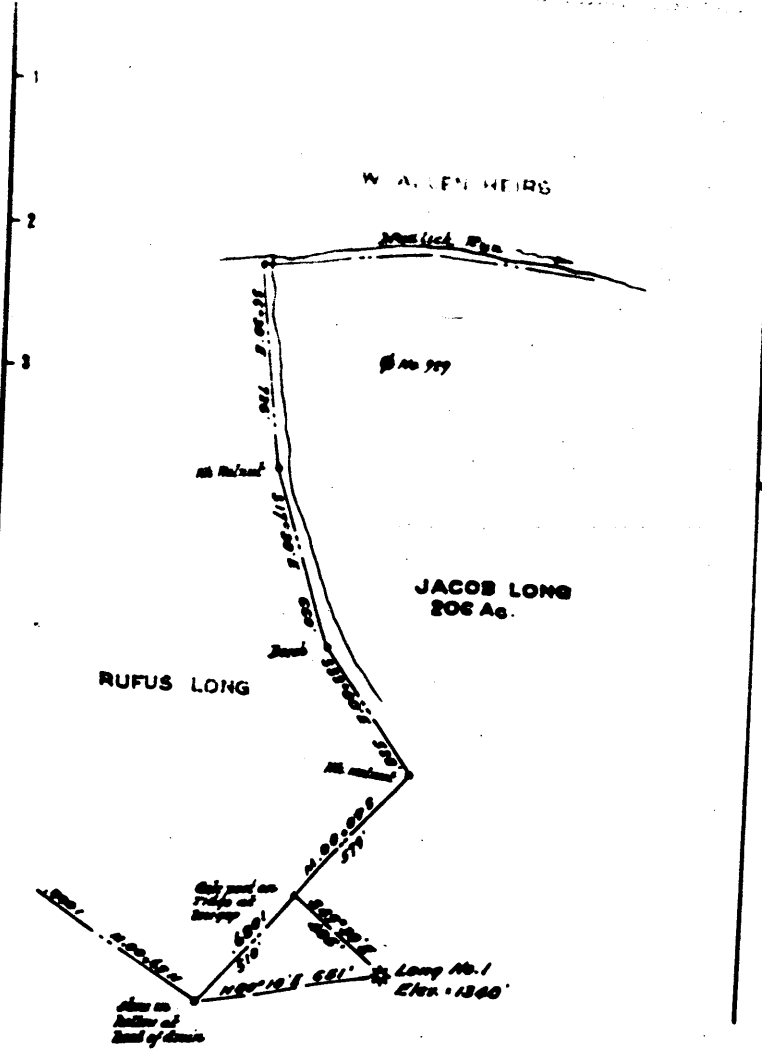

Surface owned jointly by Brooks Long, Jerry, & Bessie Long, whose address is Silver Hill, West Virginia. Coal purchased by Trucks from Pittsburgh & Ohio Coal Co. by Mr. & Mrs. Bernard Simpson, through National Gas Co. well No. 6659

New Location
 Drill Deeper
 Abandonment


Company **VALLEY STEEL PRODUCTS CO.**
 Address **St. Louis, Mo.**
 Firm **Jacob Long**
 Tract **Area 206** Lease No. _____
 Well (Farm) No. **602** Serial No. _____
 Elevation (Spirit Level) **1340**
 Geographic **Littleton**

STATE OF WEST VIRGINIA
 DEPARTMENT OF MINES
 OIL AND GAS DIVISION
 CHARLESTON

WELL LOCATION M
 FILE NO. **WGT-942-B**

A. Shows location of well as United

WELL RECORD

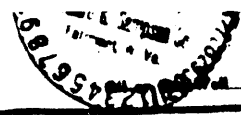

30942

Permit No. _____
 Company Valley Steel Products Company
 Address St. Louis, Mo.
 Farm Jacob Long Acres 206
 Location (waters) Mudlick Run
 Well No. 1 (Hope #6459) Elev. 1340'
 District Center County Wetzel
 The surface of tract is owned in fee by Brooke Long
Jerry & Susie Long Silver Hill W.V.
 Mineral rights are owned by _____
 Address _____
 Drilling commenced August 17, 1927
 Drilling completed October 29, 1927
 Date Shot From _____ To _____
 With _____

Casing and Tubing	Used in Drilling	Left in Well	Features
Size			Kind of Packer
10			
12	645	645'	Size of
16	777'	777'	
20	2240'	2240'	Depth cut
24	3163'	3163'	
28/16			Perf. top
3			Perf. bottom
4			Perf. top
5			Perf. bottom

Open Flow /10ths Water in _____ Inch
 /10ths Merc. in _____ Inch
 Volume _____ Cu. Ft.
 Rock Pressure _____ lbs. hrs.
 Oil _____ bbls. 1st 24 hrs.
 Fresh water _____ feet
 Salt water _____ feet

CASING CEMENTED _____ SIZE _____ No. Ft. _____ Date _____
 COAL WAS ENCOUNTERED AT _____ FEET _____ INCHES
 _____ FEET _____ INCHES FEET _____ INCHES
 _____ FEET _____ INCHES FEET _____ INCHES

Formation	Color	Hard or Soft	Top	Bottom	Oil, Gas or Water	Depth Found	Remarks
Injun Sand			2434	2675			
Thirty-Foot Sand			3228	3236			
Gordon Stray			3283	3308'			
Total Depth				3308'			



