


30953
30954

Church



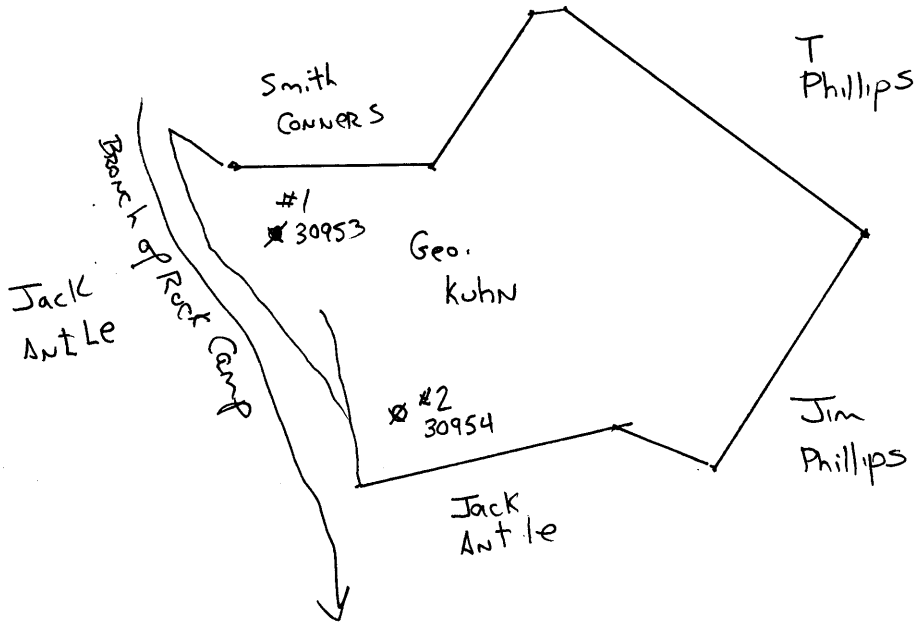

1370

STATE OF WEST VIRGINIA
DEPARTMENT OF MINES
OIL AND GAS DIVISION

WELL RECORD

Permit No. _____

Oil or Gas Well _____ (KIND)

Company W. V. Bissett et al
 Address Deer Valley, W. Va.
 Farm Geo. Kuhn Acres 57
 Location (waters) _____
 Well No. 1 Elev. 1105
 District Church County Wetzel
 The surface of tract is owned in fee by Estelle Holch
Marriech Address W. Va.
 Mineral rights are owned by Coal - Everett F.
Coore Address oundsville, W. Va.
 Drilling commenced no record
 Drilling completed _____
 Date Shot _____ From _____ To _____
 With _____

Casing and Tubing	Used in Drilling	Left in Well	Packers
Size			Kind of Packer
16			
13			
10	200	200	Size of
8 1/4	1263	1263	
6 1/2	2023	2023	Depth set
5 3/16			
3			Perf. top
2			Perf. bottom
Liners Used			Perf. top
			Perf. bottom

Open Flow _____ /10ths Water in _____ Inch
 _____ /10ths Merc. in _____ Inch
 Volume _____ Cu. Ft.
 Rock Pressure _____ lbs. _____ hrs.
 Oil _____ bbls., 1st 24 hrs.
 Fresh water _____ feet _____ feet
 Salt water _____ feet _____ feet

CASING CEMENTED _____ SIZE _____ No. Ft. _____ Date _____

COAL WAS ENCOUNTERED AT 750 FEET 40 INCHES
053 FEET 04 INCHES FEET INCHES
 FEET INCHES FEET INCHES

Formation	Color	Hard or Soft	Top	Bottom	Oil, Gas or Water	Depth Found	Remarks
Coal			750	754			
Shale			853	860			
Shale			1063	1062			
Shale			1300	1411			
Shale			1400	1500			
Shale			1753	1795			
Shale			2035	2090			
Shale			2038	2340			
Shale			2718	2733			
Shale			2860	2892			
Shale			2911	2922			
Shale				2922			
Total depth				2920			



(Over)
MAY 21 1952