Latitude

2.64s .10w

Topo Location

7.5' Loc.\_\_\_\_\_ 15' Loc.\_\_\_\_ (calc.)

Company Santee Oil & Gas Co.

Farm Mary Bartrug x1


15' Quad \_\_\_\_\_\_\_\_(sec.)

7.5' Quad Hundred

District Church

WELL LOCATION PLAT

County 163 Permit 30958

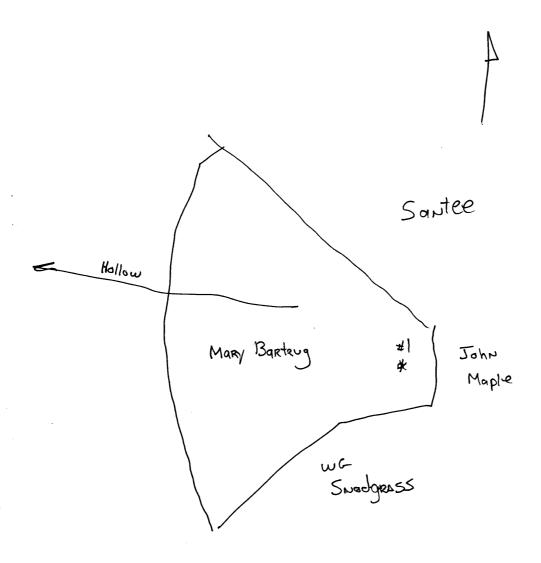



## STATE OF WEST VIRGINIA DEPARTMENT OF MINES

OIL AND GAS DIVISION





## WELL RECORD

*	<del> </del>						(KIND)
Fin	ntee 011 ndred, W.	& Gas Co. Va.		Casing and Tubing	Used in Drilling	Left in Well	Packers
Address			42				
Farm				Size			
	s)		Elev. 1431	16			Kind of Packer
Well No.	7 1 77 A 10		tzel	13			
	uron	County	<del> </del>	-	-1	e e	Size of
				10	1673	1673	Size of
Address Mineral rights are owned by				8¼ 6%	2255	2255	Depth set
				5 3/16			Jopan Source
Drilling commenced				3	i i		Perf. top
· · · · · · · · · · · · · · · · · · ·				2			Perf. bottom
Date ShotTo							Perf. top
				Diners Oseu			Perf. bottom
		ž					Feri. bottom
-	-		Inch		ianimat)	CITE	No. Ft. Date
	· ·		Inch	CASING CEM.	ENTED	_5124	INO. Pt.
			Cu. Fthrs.			1262	<u> </u>
				COAL WAS E	NCOUNTEREI	AT	FEET INCHES
			bbls., 1st 24 hrs.	ינוינו	TINC		FEET INCHES
Salt water		feet	feet		TINC	HES	FEET INCHES
Formation	Color	Hard or Soft	Тор	Bottom	Oil, Gas or Water	Depth Found	Remarks
Pittsburgh let Salt 2nd Salt S Red Cave Maxon Sand Pay Pay Total Dept	Sanđ Sand		1262 2065 2201 2343 2385 2418-2420 2428	2141 2255 2385 2436 2436			
		NOV 195 WEST VIRGIN CORPANIMENT OF	re Giodi	\$ #			