


30967

Clay



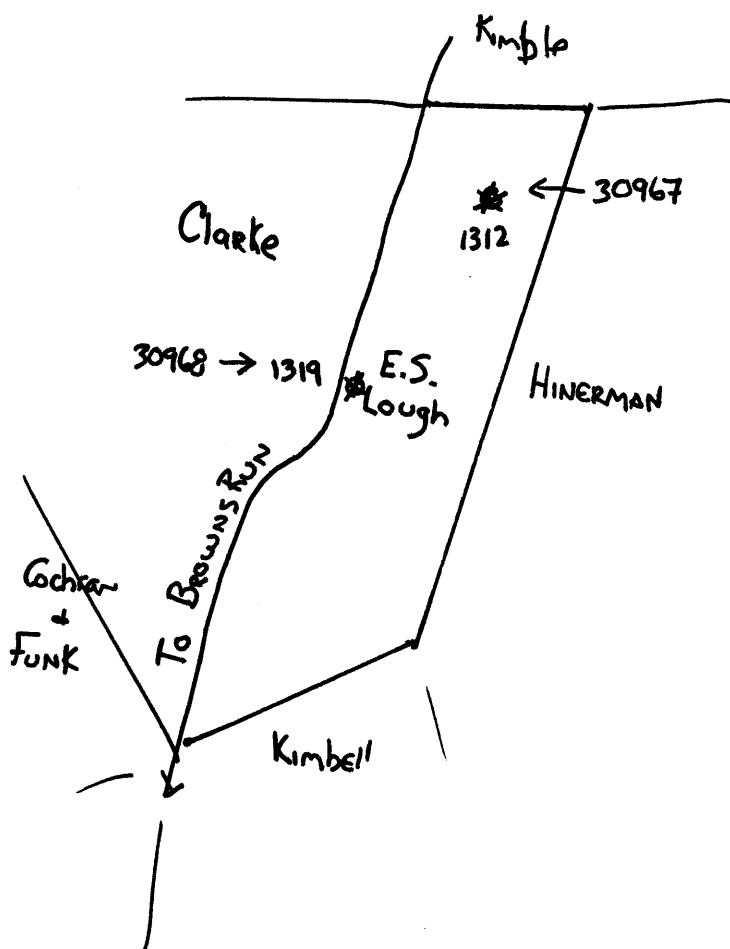

STATE OF WEST VIRGINIA
DEPARTMENT OF MINES
OIL AND GAS DIVISION

1406

No 957A

WELL RECORD
WELL TO BE ABANDONED

Oil or Gas Well GAS
(KIND)

Company CARNEGIE NATURAL GAS COMPANY
Address 1015 Fyick Building, Pittsburgh, Pa.
Farm E. S. Lough Acres 30
Location (waters) Brown's Run
Well No. 1312 Elev. 1335'
District Clay County Wetzel
The surface of tract is owned in fee by Perry Kirby
Akron Address Ohio
Mineral rights are owned by Floresen Lough,
75 Vine Street, Address Shimston, W. Va.
Drilling commenced 8-13-25
Drilling completed 8-28-25
Date Shot From To
With

Casing and Tubing	Used in Drilling	Left in Well	Packers
Size			
16			Kind of Packer
13			
10			Size of
8 3/4	114	114	
6 3/4	933	933	Depth set
5 3/16			
3			Perf. top
2			Perf. bottom
Liners Used			Perf. top
			Perf. bottom

Open Flow /10ths Water in _____ Inch
/10ths Merc. in _____ Inch
Volume _____ Cu. Ft.
Rock Pressure _____ lbs. _____ hrs.
Oil _____ bbls., 1st 24 hrs.
Fresh water _____ feet _____ feet
Salt water _____ feet _____ feet

CASING CEMENTED _____ SIZE _____ No. Ft. _____ Date _____
COAL WAS ENCOUNTERED AT **681** FEET _____ INCHES
942 FEET _____ INCHES **1056** FEET _____ INCHES
_____ FEET _____ INCHES _____ FEET _____ INCHES

Formation	Color	Hard or Soft	Top	Bottom	Oil, Gas or Water	Depth Found	Remarks
Waynesburg Coal			681	684			
Mapleton Coal			942	946	Gas		
Pittsburgh Coal			1056	1062	Gas		
Total Depth				1083			



FEB 11 1953

Formation	Color	Hard or Soft	Top	Bottom	Oil, Gas or Water	Depth Found	Remarks

Date May 1, 19 52

APPROVED CARNEGIE NATURAL GAS COMPANY, Owner

By B. H. Archer
(Title) Land Agent