


Latitude

Longitude

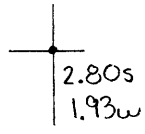

Topo Location

7.5' Loc. _____ 15' Loc. _____
 _____ (calc.) _____

Company Carnegie Nat Gas Co

Farm Henry Church #3


15' Quad _____
(sec.)

7.5' Quad Hundred

District Clay

WELL LOCATION PLAT

County 103 Permit 30971

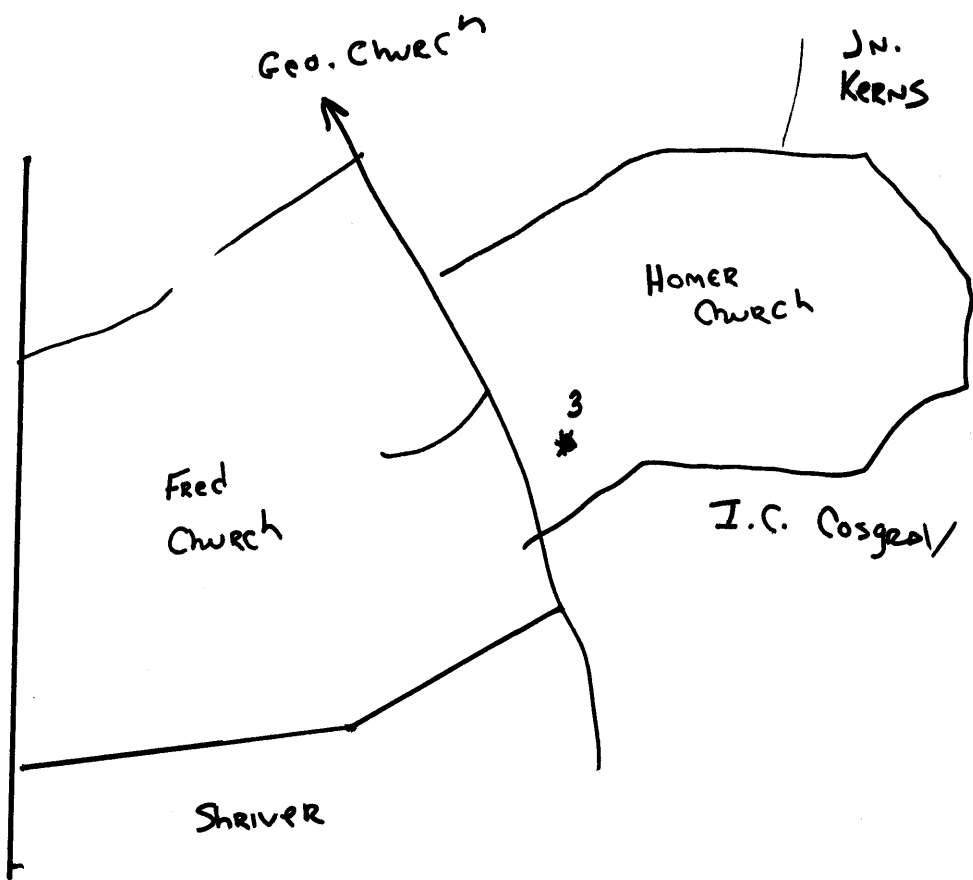



STATE OF WEST VIRGINIA
DEPARTMENT OF MINES
OIL AND GAS DIVISION

1453

Ad 971-A

WELL RECORD
WELL TO BE ABANDONED

Oil or Gas Well Oil
(KIND)

Company Carnegie Natural Gas Company
Address 1015 Frick Building, Pittsburgh, Pa.
Farm Henry Church Acres 170
Location (waters) _____
Well No. 3 Elev. 1015'
District Clay County Wetzel
The surface of tract is owned in fee by Homer Church
Littleton Address West Virginia
Mineral rights are owned by See Below
Address _____
Drilling commenced 6-15-1900 D.D. 5-12-08
Drilling completed 10-17-1900 D.D. 6-6-08
Date Shot _____ From _____ To _____
With _____
Open Flow _____ /10ths Water in _____ Inch
_____ /10ths Merc. in _____ Inch
Volume _____ Cu. Ft.
Rock Pressure _____ lbs. _____ hrs.
Oil _____ bbls., 1st 24 hrs.
Fresh water _____ feet _____ feet
Salt water _____ feet _____ feet

Casing and Tubing	Used in Drilling	Left in Well	Packers
Size			
16			Kind of Packer
13			
10	<u>199</u>	<u>199</u>	Size of
8 3/4	<u>1165</u>	<u>None</u>	
6 5/8	<u>1737</u>	<u>1737</u>	Depth set
5 3/16	<u>1960</u>	<u>1960</u>	
3			Perf. top
2	<u>2860</u>	<u>2860</u>	Perf. bottom
Liners Used			Perf. top
			Perf. bottom

CASING CEMENTED _____ SIZE _____ No. Ft. _____ Date _____
COAL WAS ENCOUNTERED AT 635 FEET _____ INCHES
740 FEET _____ INCHES FEET _____ INCHES
_____ FEET _____ INCHES FEET _____ INCHES

Formation	Color	Hard or Soft	Top	Bottom	Oil, Gas or Water	Depth Found	Remarks
Mapleton coal			635				
Pittsburgh coal			740				
Little Dunkard			1080	1100			
Big Injun Sand			1963		Gas	1972	
Total Depth 10-17-1900				2016			
Big Injun Sand				2245			
50 Foot Sand			2720	2780			
Gordon Stray			2795	2820			
Gordon Sand			2830		Oil	2847	
Total Depth 6-6-08				2860			
Mineral Rights are owned by:							
Clarence Cosgray, Knob Fork, W. Va.							
A. P. Mason, Hundred, W. Va.							
J. B. Church, Star Route #2, Box #7, Burton, W. Va.							



Formation	Color	Hard or Soft	Top	Bottom	Oil, Gas or Water	Depth Found	Remarks

Date June 6, 1952

APPROVED CARNEGIE NATURAL GAS COMPANY, Owner

By B.H. Tucker
(Title) **Land Agent**